

74

MISSISSIPPI  
BOARD OF WATER COMMISSIONERS  
416 North State Street  
Jackson, Mississippi 39201

WALTHALL  
A 74  
3-20-72

WATER WELL DRILLERS LOG

March 20 1972 Chester Bevers Walthall -  
date well completed firm name county well located

LANDOWNER: Charles A. D. Bailey  
R.F.D. Jaynes  
(mailing address)

WELL LOCATION:  
sec. 13 T. 4 N. R. 9 E  
3 miles NE of Pinedale  
(distance) (direction) (nearest town)

WELL PURPOSE: Home  
(home, irrigation, municipal, industrial)

WELL COMPLETION DATA:  
(1) diameter (inches) 4"  
(2) total depth (feet) 134  
(3) static water level (feet) 95 below top of ground  
(4) casing Plastic Bottom  
(material) (depth)  
(5) screen 6' 128'  
(length) (depth to top)  
4" Plastic  
(size) (material)  
(6) pump 1/2 HP 18  
(type power) (yield gpm.)  
elect  
(7) electric log No  
(yes or no)  
(organization running log)

description of formations encountered	from	to
Red clay	0	26
Red cherty sand	26	70
granular cherty sand	70	85
Sand	85	98
Sandy sand	112	120
Pink chert gravel	120	128
Small gravel sand	128	134


JUN 30 1972

MISS. ED. UD  
WATER BUREAU

(8) how well bottom plugged  
wooden plug  
DRILLERS REMARKS: New location

If well telescopes please sketch and show depths.

GROUND LEVEL

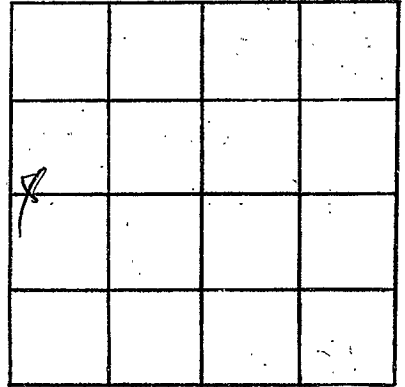

SECTION 13

Please indicate well location X.

ADDITIONAL INFORMATION

If more than one screen,  
show locations of each on sketch.