

74

WALTHALL  
A 75  
4-19-72

MISSISSIPPI  
BOARD OF WATER COMMISSIONERS  
416 North State Street  
Jackson, Mississippi 39201

WATERWELL DRILLERS LOG

April 19 1972 Chester Reeves Walthall  
date well completed firm name county well located

LANDOWNER

John Westbrook  
Rt 3, Box 6, Bayess  
(mailing address)

description of formations encountered

from to

Red clay	0	17
Red chert	17	27
Red cherty sand	28	27
Coarse sand	27	26
Small gravel bank	26	23

WELL LOCATION:

sec. 23 T 4 N R 10 E  
13 miles N-W of Tillatona  
(distance) (direction) (nearest town)

WELL PURPOSE:

house  
(home, irrigation, municipal, industrial)

WELL COMPLETION DATA:

- (1) diameter (inches) 4 1/2"
- (2) total depth (feet) 103
- (3) static water level (feet) 76 below top of ground
- (4) casing Plast ballam  
(material) (depth)
- (size) If telescope see back.
- (5) screen 6' 97'  
(length) (depth to top)
- 4" Plast  
(size) (material)
- (6) pump eddy  
(HP) (yield gpm)
- Elect  
(type power)
- (7) electric log No  
(yes or no)

(organization running log)

(8) how well bottom plugged  
wooden plug


DRILLERS REMARKS:

No previous well

APR 30 1972

If well telescopes please sketch and show depths.

GROUND LEVEL

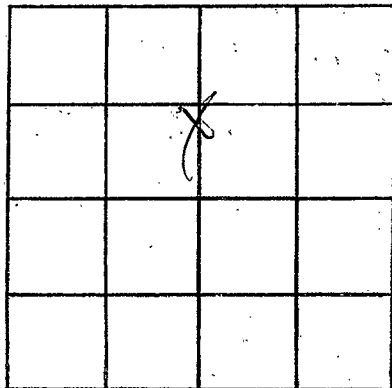

SECTION 23

Please indicate well location X.

ADDITIONAL INFORMATION

If more than one screen,  
show locations of each on sketch.