

WALTHALL  
A 76  
5-25-72

MISSISSIPPI  
BOARD OF WATER COMMISSIONERS  
416 North State Street  
Jackson, Mississippi 39201

WATER WELL DRILLERS LOG

date well completed May 25 1972 firm name Chester Keener county well located Walthall

LANDOWNER: Tex Craft  
Rt 3, Jay's  
(mailing address)

description of formations encountered	from	to
<u>Red clay</u>	<u>0</u>	<u>26</u>
<u>Red sand &amp; gravel</u>	<u>26</u>	<u>94</u>
<u>Red gravel &amp; sand</u>	<u>94</u>	<u>106</u>

WELL LOCATION:  
sec. 14 T 4 N R 10 E  
4 miles SW of Spartanville  
(distance) (direction) (nearest town)

WELL PURPOSE: Home  
(home, irrigation, municipal, industrial)

- WELL COMPLETION DATA:
- (1) diameter (inches) 4"
  - (2) total depth (feet) 106
  - (3) static water level (feet) 73 <sup>below</sup>/<sub>above</sub> top of ground
  - (4) casing Plast Bottom  
(material) (depth)  
         if telescope see back.  
(size)
  - (5) screen 6' 100  
(length) (depth to top)  
4" Plast  
(size) (material)
  - (6) pump none none  
(HP) (yield gpm)  
1 bucket  
(type power)
  - (7) electric log no  
(yes or no)  
          
(organization running log)


(8) how well bottom plugged wooden plug

DRILLERS REMARKS:  
No pressure well

JUN 30 1972

If well telescopes please sketch and show depths.

GROUND LEVEL

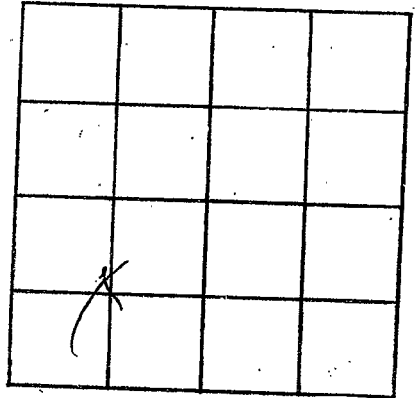

SECTION 14

Please indicate well location X.

ADDITIONAL INFORMATION

If more than one screen,  
show locations of each on sketch.