

WALTHALL

A 77

5-23-72

MISSISSIPPI BOARD OF WATER COMMISSIONERS  
416 North State Street  
Jackson, Mississippi 39201

**CODED**

WATER WELL DRILLERS LOG

23 May

1972

SE Walthall

WALTHALL

date well completed

firm name

county well located

LANDOWNER:

Jessie B. Conely

(mailing address)

WELL LOCATION:

sec 20 T 4 N R 10 E  
2 miles S of Frown

WELL PURPOSE:

(home, irrigation, municipal, industrial)

WELL COMPLETION DATA:

- (1) diameter (inches) 4
- (2) total depth (feet) 169
- (3) static water level (feet) 90 below top of ground
- (4) casing (material) PI, (depth) 163
- (5) screen (length) 6, (depth to top) 163
- (6) pump (HP) 1/2, (yield gpm) 8
- (7) electric log (yes or no)

(organization running log)

(8) how well bottom plugged used

DRILLERS REMARKS:

description of formations encountered

from

to

Clay	0	15
Red Shale	15	60
Clay	60	90
Sandstone	90	110
Clay	110	130
Shale	130	169


**CODED**

JUL 25 1972

MISS. DIV. OF WATER RESOURCES

If well telescopes please sketch and show depths.

GROUND LEVEL

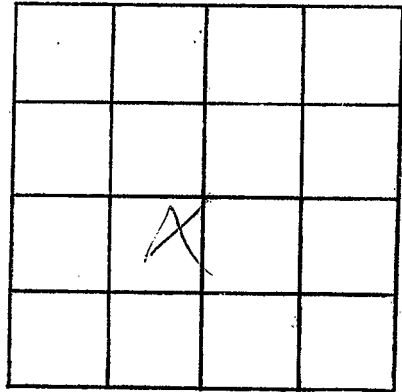

SECTION 20

Please indicate well location X.

ADDITIONAL INFORMATION

If more than one screen, show locations of each on sketch.