

WALTHALL
A80
4-30-73

MISSISSIPPI
BOARD OF WATER COMMISSIONERS
416 North State Street
Jackson, Mississippi 39201

CODED

WATER WELL DRILLERS LOG

4-30-1973 date well completed
Fitzgerald Well Inc firm name
Walthall county well located

LANDOWNER:

J. V. Burnett
R.R. Jones
(mailing address)

description of formations encountered

from to

Red clay	0	20
Red sandstone	20	80
Coarse sandstone	80	94

WELL LOCATION:

sec. 17 T-4 N R-10 E
2 miles N of Grove
(distance) (direction) (nearest town)

WELL PURPOSE:

(home, irrigation, municipal, industrial)

WELL COMPLETION DATA:

- (1) diameter (inches) 4
- (2) total depth (feet) 94
- (3) static water level (feet) 70 below above top of ground.
- (4) casing plastic 86, (material) (depth)
4 if telescope see back. (size)
- (5) screen 8, 86 (length) (depth to top)
4, plastic (size) (material)
- (6) pump 1/2, 10 (HP) (yield gpm)
elec (type power)
- (7) electric log no (yes or no)
(organization running log)
- (8) how well bottom plugged wood plug


CODED

DRILLERS REMARKS:

MAY 8 1973

If well telescopes please sketch and show depths.

GROUND LEVEL

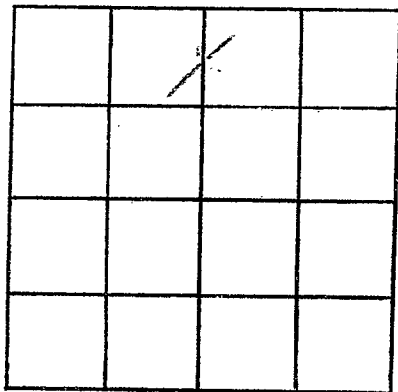

SECTION 17

Please indicate well location X.

ADDITIONAL INFORMATION

If more than one screen,
show locations of each on sketch.