

WALTHALL  
A82  
4-013-73  
4-

MISSISSIPPI  
BOARD OF WATER COMMISSIONERS  
416 North State Street  
Jackson, Mississippi 39201

CODED

WATER WELL DRILLERS LOG

date well completed 4-13 1973 firm name Green Water Well county well located Walthall

LANDOWNER: Alton Boyd  
Rt 5

description of formations encountered Citronelle

from 0 to 110

Jaylertown Miss.  
(mailing address)

WELL LOCATION:  
sec. 36 T. 4 N. R. 10 E.  
5 W  
10 miles N of Jaylertown  
(distance) (direction) (nearest town)

WELL PURPOSE: Home  
(home, irrigation, municipal, industrial)

WELL COMPLETION DATA:

- (1) diameter (inches) 6'
- (2) total depth (feet) 90
- (3) static water level (feet) 65 below above top of ground.
- (4) casing PVC, 90  
(material), (depth)  
         if telescope see back.  
(size)
- (5) screen 6', 90  
(length) (depth to top)  
010, PVC  
(size) (material)
- (6) pump 3/4 sub, 7  
(HP) (yield gpm)  
electric  
(type power)
- (7) electric log no  
(yes or no)  
          
(organization running log)
- (8) how well bottom plugged wood


CODED

DRILLERS REMARKS:

MAY 23 1973

If well telescopes please sketch and show depths.

GROUND LEVEL

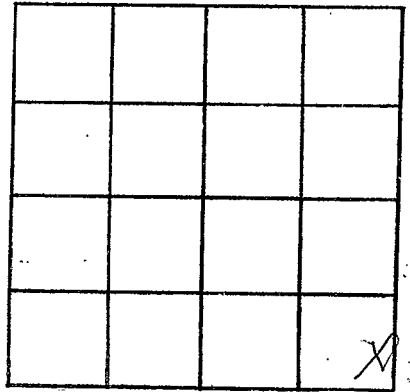

SECTION 56

Please indicate well location X.

ADDITIONAL INFORMATION

If more than one screen,  
show locations of each on sketch.