

MISSISSIPPI
BOARD OF WATER COMMISSIONERS
416 North State Street
Jackson, Mississippi 39201

WATER WELL DRILLERS LOG

CODED

A 83
WALTHALL
5-25-73

May 25 1973 date well completed
Chester Beene well firm name
county well located

LANDOWNER
Summit
McGowan
H. J. Hayes
(mailing address)

description of formations encountered	from	to
Red clay	0	22
Red sand	22	63
Sand & gravel	63	76
Red chalk	76	80
Sand & gravel	80	96

WELL LOCATION:
sec. 35 T 4 N R 10 E
11 miles N W W of Tylertown
(distance) (direction) (nearest town)

WELL PURPOSE: Home
(home, irrigation, municipal, industrial)

CODED

- WELL COMPLETION DATA:
- (1) diameter (inches) 4"
 - (2) total depth (feet) 96
 - (3) static water level (feet) 71 below top of ground.
 - (4) casing Plast. Bottom
(material) (depth)
 - (5) screen 6" 90'
(length) (depth to top)
4" Plast
(size) (material)
 - (6) pump 1/2 Sub 12
(HP) (yield gpm)
Elect
(type power)
 - (7) electric log no
(yes or no)

(organization running log)


(8) how well bottom plugged
wooden plug

DRILLERS REMARKS:
New barrel

AUG 20 1973

If well telescopes please sketch and show depths.

GROUND LEVEL

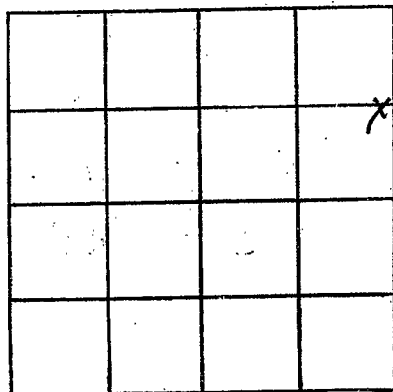

SECTION 35

Please indicate well location X.

ADDITIONAL INFORMATION

If more than one screen,
show locations of each on sketch.