

WALTHALL  
A85  
2/74

MISSISSIPPI  
BOARD OF WATER COMMISSIONERS  
416 North State Street  
Jackson, Mississippi 39201

CODED

WATER WELL DRILLERS LOG

Feb. 1974 date well completed  
E. B. Sheppard firm name  
Walthall county well located

LANDOWNER:  
Sarah Jefferson  
Julesburg, Miss.  
(mailing address)

description of formations encountered		from	to
SANDY RED CLAY		0	60
GR. SAND		60	90

WELL LOCATION:  
sec. 26 T. 4 N. R. 10 E S. 5  
11 miles N. Julesburg  
(distance) (direction) (nearest town)

WELL PURPOSE:  
(home) Irrigation, municipal, industrial

WELL COMPLETION DATA:

(1) diameter (inches) 2"

(2) total depth (feet) 90'

(3) static water level (feet) 60' below top of ground.

(4) casing (material) pl. (depth) 85'

2" if telescope see back. (size)

(5) screen (length) 5' (depth to top)

2" (size) pl. (material)

(6) pump (HP) 1 (yield gpm) 7


E (type power)

(7) electric log (yes or no) (no)

(organization running log)

(8) how well bottom plugged BWV

CODED

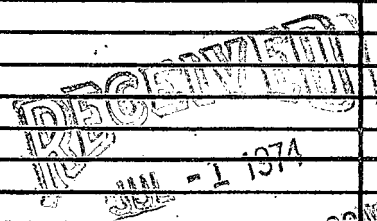


MISS. BD. OF WATER COMMISSIONERS

DRILLERS REMARKS:

If well telescopes please  
sketch and show depths.

GROUND LEVEL

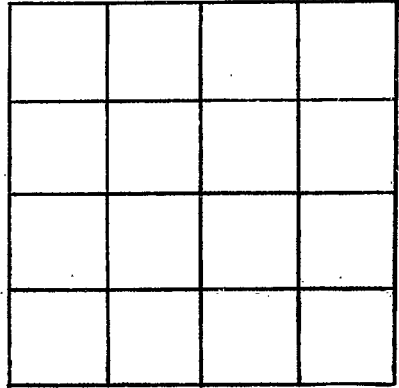

SECTION \_\_\_\_\_

Please indicate well location X.

ADDITIONAL INFORMATION

If more than one screen,  
show locations of each on sketch.