

WALTHALL
A 86
3/74

MISSISSIPPI
BOARD OF WATER COMMISSIONERS CODED
416 North State Street
Jackson, Mississippi 39201


WATER WELL DRILLERS LOG

March 1974 E.B. Sherrard Walthall
date well completed firm name county well located

| LANDOWNER: | description of formations encountered | from | to |
|--|---|----------------|------------------|
| Lessie Lee Wilson Iylertown, Miss. (mailing address) | GRAV CLAY SANDY FINE CLAY COARSE SAND + GRAVEL | 0 70 100 | 70 100 115 |
| WELL LOCATION: sec. 11 T. 4 N R. 10 E 14 miles N Iylertown (distance) (direction) (nearest town) | CODED | | |
| WELL PURPOSE: (home, irrigation, municipal, industrial) | | | |
| WELL COMPLETION DATA: (1) diameter (inches) 2" (2) total depth (feet) 115' (3) static water level (feet) 78' below above top of ground. (4) casing (material) pl. (depth) 110' 2" if telescope see back. (size) (5) screen 5' (length) (depth to top) 2" (size) pl. (material) (6) pump 1 (HP) 7 (yield gpm) E (type power) (7) electric log (yes or no) (organization running log) (8) how well bottom plugged BWV | <p style="text-align: center;">RECEIVED JUL 1 1974 MISS. BD. OF WATER COMMISSIONERS</p> | | |
| DRILLERS REMARKS: | | | |

If well telescopes please sketch and show depths.

GROUND LEVEL

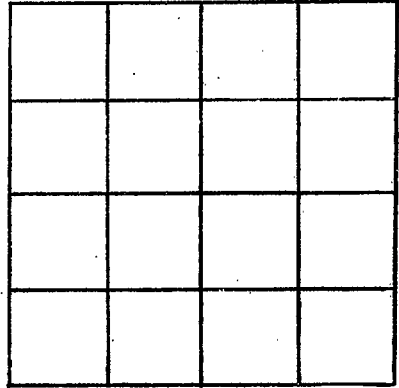

SECTION _____

Please indicate well location X.

ADDITIONAL INFORMATION

If more than one screen, show locations of each on sketch.