

WALTHALL  
A 87  
6-21-74

MISSISSIPPI  
BOARD OF WATER COMMISSIONERS  
416 North State Street  
Jackson, Mississippi 39201

WATER WELL DRILLERS LOG

CODED

6-21 1974 F. B. Caldwell Co Walthall  
date well completed firm name county well located

LANDOWNER:

Reneeth Horn

description of formations encountered

from

to

R.R. & Jones  
(mailing address)

<u>Red Clay</u>	<u>0</u>	<u>20</u>
<u>Red Soil</u>	<u>20</u>	<u>125</u>
<u>Coarse Sand &amp; gravel</u>	<u>125</u>	<u>140</u>

WELL LOCATION:

sec. 1 T. 40 S. R. 7E  
8 miles N of Princeton  
(distance) (direction) (nearest town)

WELL PURPOSE: Home  
(home, irrigation, municipal, industrial)

WELL COMPLETION DATA:

- (1) diameter (inches) 4
- (2) total depth (feet) 140
- (3) static water level (feet) 80 below above top of ground.
- (4) casing plastic, 132,  
(material) (depth)  
4 if telescope see back.  
(size)
- (5) screen 8, 132  
(length) (depth to top)  
4, plastic  
(size) (material)
- (6) pump 1/2, 10  
(HP) (yield gpm)  
elec  
(type power)
- (7) electric log no  
(yes or no)  
(organization running log)
- (8) how well bottom plugged Sand shell

CODED


RECEIVED  
JUL 10 1974

MISS. Bd. OF WATER COMMISSIONERS

DRILLERS REMARKS:

If well telescopes please sketch and show depths.

GROUND LEVEL

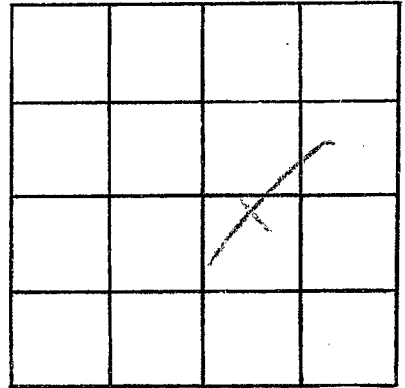

SECTION 1

Please indicate well location X.

ADDITIONAL INFORMATION

If more than one screen,  
show locations of each on sketch.