

WALTHALL
A88
9-21-73

MISSISSIPPI
BOARD OF WATER COMMISSIONERS
416 North State Street
Jackson, Mississippi 39201

CODED

WATER WELL DRILLERS LOG

Sep 21 1973 Chester Keene Walthall
date well completed firm name county well located

LANDOWNER Leonard Barnes
Rt 3 Jayess
(mailing address)

description of formations encountered	from	to
Red clay	0	17
Red Sand	17	46
Sand & Small gravel	46	62
Red chalky sand	62	100
Red gravel & sand	100	111

WELL LOCATION:
sec. 27 T 4 N 9 E R 10 E
10 miles NNE of Tipton
(distance) (direction) (nearest town)

WELL PURPOSE: Water for farm
(home, irrigation, municipal, industrial)

- WELL COMPLETION DATA:
- (1) diameter (inches) 4 1/2
 - (2) total depth (feet) 111
 - (3) static water level (feet) 49 below top of ground.
 - (4) casing Plast. Batture
(material) (depth)
 - (size) if telescope see back.
 - (5) screen 6' 105'
(length) (depth to top)
 - 4 1/2" Plast.
(size) (material)
 - (6) pump Furnished by owner
(HP) (yield gpm)
(type power)
 - (7) electric log no
(yes or no)
 - (organization running log)
 - (8) how well bottom plugged coarsely


CODED

DRILLERS REMARKS:
New location

MISSISSIPPI
BOARD OF WATER COMMISSIONERS
JAN 30 1974

If well telescopes please
sketch and show depths.

GROUND LEVEL

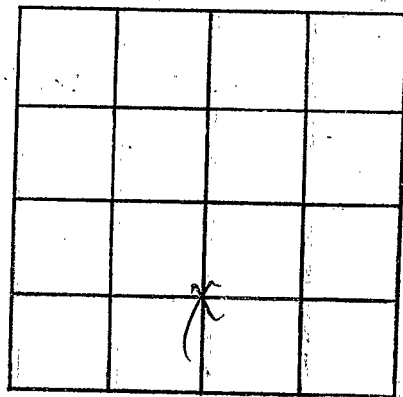

SECTION 27

Please indicate well location X.

ADDITIONAL INFORMATION

If more than one screen,
show locations of each on sketch.