

WALTHALL
A 89
7-10-74

MISSISSIPPI
BOARD OF WATER COMMISSIONERS
416 North State Street
Jackson, Mississippi 39201

CODED

WATER WELL DRILLERS LOG


July 10 1974 Chester Reeves Walthall
date well completed firm name county well located

| LANDOWNER: <u>Booker T. Budgets</u> | description of formations encountered | from | to |
|---|---------------------------------------|------|-----|
| RFD-Jayles (mailing address) | Red clay | 0 | 18 |
| WELL LOCATION: | Red cherty sand | 18 | 92 |
| sec. <u>14</u> T <u>4</u> N R <u>10</u> E <u>14</u> miles <u>NNW</u> of <u>Walthall</u> (distance) (direction) (nearest town) | Small gravel sand | 92 | 102 |
| WELL PURPOSE: <u>Home</u> (home, irrigation, municipal, industrial) | | | |
| WELL COMPLETION DATA: | | | |
| (1) diameter (inches) <u>4"</u> | | | |
| (2) total depth (feet) <u>102</u> | | | |
| (3) static water level (feet) <u>91</u> <u>below</u> top of ground. | | | |
| (4) casing <u>Plast. Ballam.</u> (material) (depth) | | | |
| (size) If telescope see back. | | | |
| (5) screen <u>6'</u> <u>96'</u> (length) (depth to top) | | | |
| <u>4"</u> <u>Plast.</u> (size) (material) | | | |
| (6) pump <u>1/2 Sub</u> <u>12</u> (HP) (yield gpm) | | | |
| <u>Electric</u> (type power) | | | |
| (7) electric log <u>no</u> (yes or no) | | | |
| (organization running log) | | | |
| (8) how well bottom plugged <u>wooden plug</u> | | | |
| DRILLERS REMARKS: <u>no previous well.</u> | | | |

RECEIVED
MAY 27 1974

If well telescopes please sketch and show depths.

GROUND LEVEL

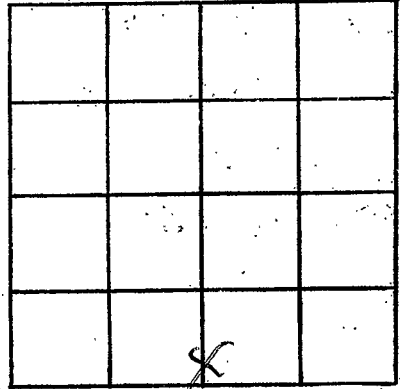

SECTION 14

Please indicate well location X.

ADDITIONAL INFORMATION

If more than one screen, show locations of each on sketch.