

WALTHALL
A 91
3-13-75

MISSISSIPPI
BOARD OF WATER COMMISSIONERS
416 North State Street
Jackson, Mississippi 39201

CODED

WATER WELL DRILLERS LOG

3-13 1975 Felg and label Ser Walthall
date well completed firm name county well located


LANDOWNER:	description of formations encountered	from	to
<u>Robert Bayal</u> <u>R.R. Jones Miss</u> (mailing address)			
WELL LOCATION: sec. <u>23</u> T. <u>4</u> N. <u>S</u> R. <u>10</u> E. <u>W</u> <u>3</u> miles <u>E</u> of <u>Eron</u> (distance) (direction) (nearest town)			
WELL PURPOSE: <u>Home</u> (home, irrigation, municipal, industrial)			
WELL COMPLETION DATA:			
(1) diameter (inches) <u>4</u>			
(2) total depth (feet) <u>146</u>			
(3) static water level (feet) <u>20</u> below above top of ground.			
(4) casing <u>plastic</u> , <u>138</u> , (material) (depth) <u>4</u> if telescope see back. (size)			
(5) screen <u>8</u> , <u>138</u> (length) (depth to top) <u>4</u> , <u>plastic</u> (size) (material)			
(6) pump <u>1/2</u> , <u>10</u> (HP) (yield gpm) <u>alu</u> (type power)			
(7) electric log <u>no</u> (yes or no) (organization running log)			
(8) how well bottom plugged <u>level floor</u>			
DRILLERS REMARKS:			

CODED

RECEIVED
APR 2 1975

If well telescopes please sketch and show depths.

GROUND LEVEL

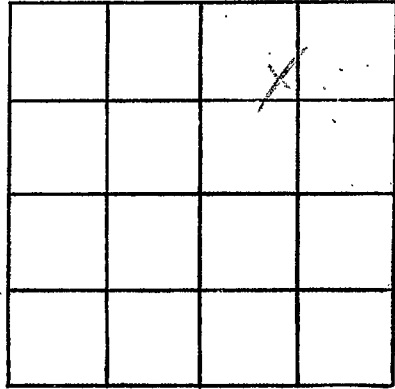

SECTION 23

Please indicate well location X.

ADDITIONAL INFORMATION

A series of horizontal lines for recording additional information.

If more than one screen, show locations of each on sketch.