

Walthall
 # 93
 8/74

MISSISSIPPI
 BOARD OF WATER COMMISSIONERS
 416 North State Street
 Jackson, Mississippi 39201

WATER WELL DRILLERS LOG

CODED

August 1974 E. B. Sheppard Walthall
 date well completed firm name county well located


LANDOWNER:	description of formations encountered	from	to
Celestine Covant Rt. 3 - Jayess, Ms. (mailing address)			
WELL LOCATION:	LOOSE SANDY STREAKS MIXED WITH BAY CHALK COARSE SAND & SMALL PEA GRAVEL	0	80'
sec. 11 T. 40 N. R. 10 E. 15 miles N Jayestown (distance) (direction) (nearest town)		80	102'
WELL PURPOSE: (home, irrigation, municipal, industrial)			
WELL COMPLETION DATA:			
(1) diameter (inches) 2"			
(2) total depth (feet) 102'			
(3) static water level (feet) 65' below top of ground.			
(4) casing pl. 97' (material) (depth) 2" if telescope see back. (size)			
(5) screen 5' (length) (depth to top) 2" pl. (size) (material)			
(6) pump 1 (HP) 7 (yield gpm) E (type power)			
(7) electric log (yes or no)			
(organization running log)			
(8) how well bottom plugged B.W.V.			
DRILLERS REMARKS:			

RECEIVED
 MAY 8 1975

MISS. BD. OF WATER COMMISSIONERS

If well telescopes please sketch and show depths.

GROUND LEVEL

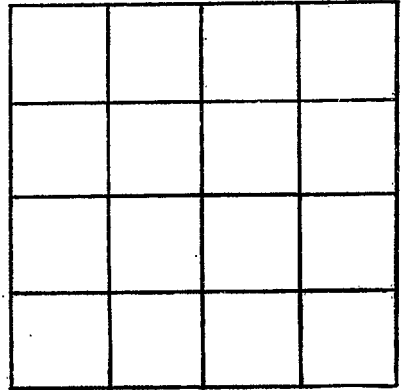

SECTION _____

Please indicate well location X.

ADDITIONAL INFORMATION

If more than one screen, show locations of each on sketch.