

A 94  
Walthall  
4/5/75

MISSISSIPPI  
 BOARD OF WATER COMMISSIONERS  
 416 North State Street  
 Jackson, Mississippi 39201

CODED

WATER WELL DRILLERS LOG

4-5 19 75 Fitzgerald Well Serv Walthall  
 date well completed firm name county well located


LANDOWNER:	description of formations encountered	from	to
<u>Billy Boyd</u>	<u>Red Clay</u>	<u>0</u>	<u>20</u>
<u>R.R. Jones</u> (mailing address)	<u>Red Sand</u>	<u>20</u>	<u>70</u>
<b>WELL LOCATION:</b>	<u>Red Chalk</u>	<u>70</u>	<u>125</u>
sec. <u>31</u> T. <u>4</u> N. R. <u>10</u> E. <u>4</u> miles <u>SE</u> of <u>Cactus Creek</u> (distance) (direction) (nearest town)	<u>Red Sand</u>	<u>100</u>	<u>125</u>
<b>WELL PURPOSE:</b> <u>Home</u> (home, irrigation, municipal, industrial)	<u>Coarse sand &amp; gravel</u>	<u>125</u>	<u>135</u>
<b>WELL COMPLETION DATA:</b>			
(1) diameter (inches) <u>4</u>			
(2) total depth (feet) <u>135</u>			
(3) static water level (feet) <u>25</u> below top of ground.			
(4) casing <u>plastic</u> , <u>127</u> (material) (depth)			
<u>4</u> if telescope see back. (size)			
(5) screen <u>8</u> , <u>127</u> (length) (depth to top)			
<u>4</u> , <u>plastic</u> (size) (material)			
(6) pump <u>1/2</u> , <u>10</u> (HP) (yield gpm)			
<u>Electric</u> (type power)			
(7) electric log <u>yes</u> (yes or no)			
(organization running log)			
(8) how well bottom plugged <u>Small block</u>			
<b>DRILLERS REMARKS:</b>			

REGISTERED  
 APR 10 1975

MISS. BLD. OF WATER COMMISSIONERS

If well telescopes please sketch and show depths.

GROUND LEVEL

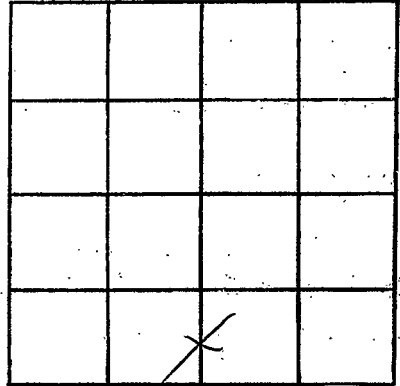

SECTION 31

Please indicate well location X.

ADDITIONAL INFORMATION

A series of horizontal lines for writing additional information.

If more than one screen, show locations of each on sketch.