

Walthall  
A 96

MISSISSIPPI  
BOARD OF WATER COMMISSIONERS  
416 North State Street  
Jackson, Mississippi 39201

CODED

WATER WELL DRILLERS LOG


9-3 1975 *Flynn & Bell* Walthall  
date well completed firm name county well located

LANDOWNER:	description of formations encountered	from	to
<i>Percy McCallum</i>	<i>Red clay</i>	0	20
<i>R.B. Jones min. (mailing address)</i>	<i>Red sand Coarse sand &amp; gravel</i>	20 110	110 123
<b>WELL LOCATION:</b>			
sec. <u>17</u> T. <u>4</u> (N) R. <u>10</u> (E) 13 <u>4</u> S W <u>2</u> miles <u>N</u> of <u>Evans</u> (distance) (direction) (nearest town)			
<b>WELL PURPOSE:</b> <u>HO</u> (home, irrigation, municipal, industrial)			
<b>WELL COMPLETION DATA:</b>			
(1) diameter (inches) <u>4</u>			
(2) total depth (feet) <u>123</u>			
(3) static water level (feet) <u>45</u> below top of ground.			
(4) casing <u>plastic</u> , <u>115</u> , (material) (depth)			
<u>4</u> if telescope see back. (size)			
(5) screen <u>8</u> , <u>115</u> (length) (depth to top)			
<u>4</u> , <u>plastic</u> (size) (material)			
(6) pump <u>1/2</u> , <u>10</u> (HP) (yield gpm)			
<u>alt</u> (type power)			
(7) electric log <u>no</u> (yes or no)			
(organization running log)			
(8) how well bottom plugged, <u>sealed</u>			
<b>DRILLERS REMARKS:</b>			

WALTHALL  
MAY 5 1975  
MISS. BOARD OF WATER COMMISSIONERS

If well telescopes please  
sketch and show depths.

GROUND LEVEL

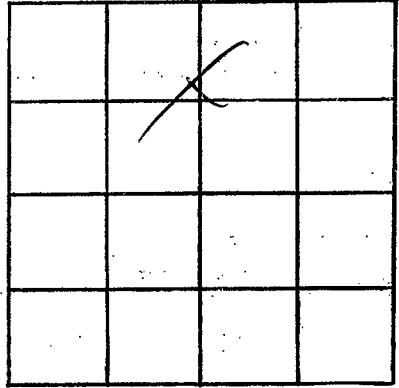

SECTION 17

Please indicate well location X.

ADDITIONAL INFORMATION

If more than one screen,  
show locations of each on sketch.