

Walthall  
A 107  
12/1/81

MISSISSIPPI  
BOARD OF WATER COMMISSIONERS  
416 North State Street  
Jackson, Mississippi 39201

CODED

WATER WELL DRILLERS LOG

12-1 date well completed      1981 Fitzgerald Well Sew firm name      Walthall county well located

LANDOWNER:  
Jimmy Engle  
R.R. Jacobs, Mrs.  
(mailing address)

description of formations encountered	from	to
Red clay	0	20
Red sand	20	140
Coarse sand & gravel	140	160
White clay	160	180
Pea gravel	180	200

WELL LOCATION:  
sec. 28 T 4 (N) R 10 (E)  
S W  
2 miles S of ENOH  
(distance) (direction) (nearest town)

WELL PURPOSE: IHR  
(home, irrigation, municipal, industrial)

- WELL COMPLETION DATA:
- (1) diameter (inches) 6
  - (2) total depth (feet) 200
  - (3) static water level (feet) 48 below above top of ground.
  - (4) casing PVC 140  
(material) (depth)  
4 1/2" If telescope see back.  
(size)
  - (5) screen 40' 140  
(length) (depth to top)  
4 1/2" PVC  
(size) (material)
  - (6) pump 10 240  
(HP) (yield gpm)  
Elec  
(type power)
  - (7) electric log no  
(yes or no)  
(organization running log)
  - (8) how well bottom plugged level shank

CODED

DEPT. OF NATURAL RESOURCES  
BUREAU OF LAND & WATER RESOURCE



JAN 15 1982

RECEIVED

DRILLERS REMARKS:

If well telescopes please sketch and show depths.

GROUND LEVEL

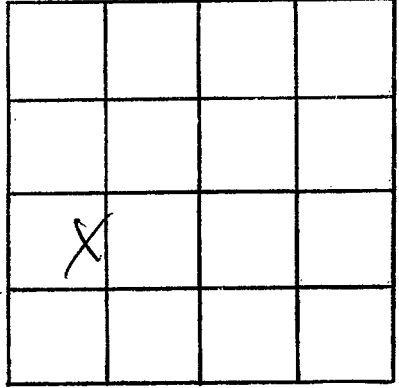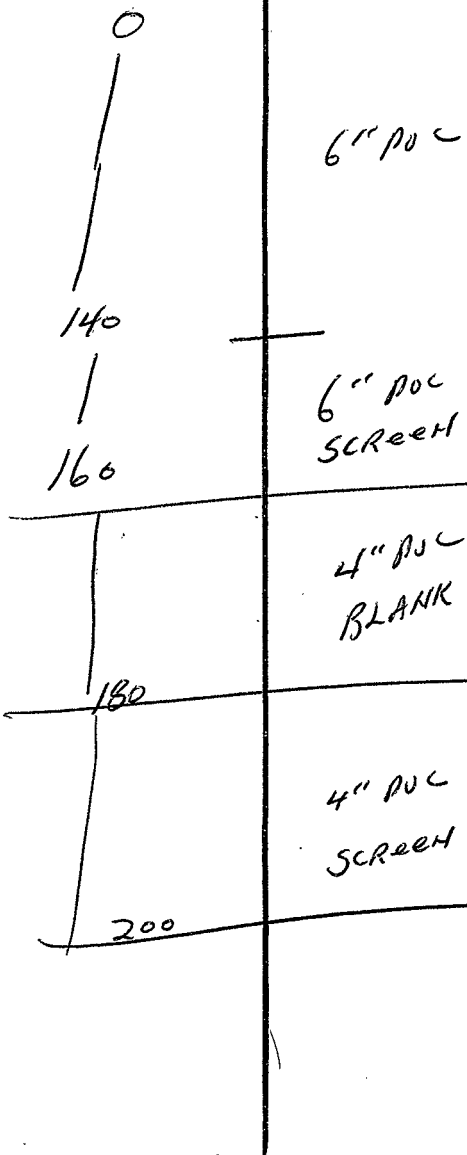

SECTION 28

Please indicate well location X.

ADDITIONAL INFORMATION

A series of horizontal lines for writing additional information.

If more than one screen, show locations of each on sketch.