

MISSISSIPPI DEPARTMENT OF NATURAL RESOURCES

Bureau of Land and Water Resources

Southport Mall

P.O. Box 10631

Jackson, Mississippi 39209

CODED

WATER WELL DRILLERS LOG

Griner Drilling Service, Inc.

Walthall

A109
WALTHALL CO
12-21-83

12-21-83
date well completed

Griner Drilling Service, Inc.
firm name

Walthall
county well located

LANDOWNER:	description of formations encountered	from	to	
See Land Drilling Co. P.O. Box 34 Magnolia, Ms. 39652 (mailing address)				Sand, pea gravel
WELL LOCATION: 1980' N + 710' W Sec. 35 T. 4 N R. 10 E of Ferrywood Lumber Co. Manning Crossing (distance) miles (direction) (nearest town)	SW NE NE NW SE			
WELL PURPOSE: oil field supply (home, irrigation, municipal, industrial)				
WELL COMPLETION DATA:				
(1) diameter (inches) <u>3"</u>	CODED			
(2) total depth (feet) <u>273'</u>				
(3) static water level (feet) <u>100'</u> ^{below} above top of ground.				
(4) casing <u>steel</u> <u>273'</u> (material) (depth)				
<u>3"</u> (size) if telescope see back.				
(5) screen <u>42'</u> <u>231'</u> (length) (depth to top)				
<u>3"</u> <u>perforated</u> (size) (material)				
(6) pump <u>—</u> <u>75-80</u> (HP) (yield gpm)				
<u>AC</u> (type power)				
(7) electric log <u>—</u> (yes or no)				
<u>—</u> (organization running log)				
(8) how well bottom plugged <u>orange peel</u>				
DRILLERS REMARKS: <u>—</u>				


DEPT. OF NATURAL RESOURCES
BUREAU OF LAND & WATER RESOURCES

JAN 27 1984

RECEIVED

If well telescopes please sketch and show depths.

GROUND LEVEL

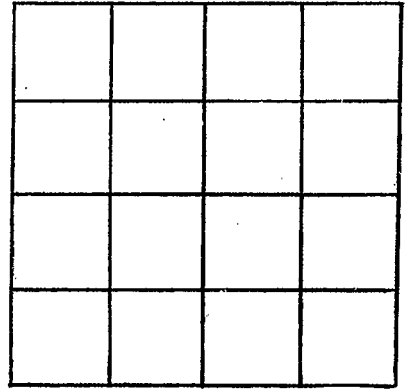

SECTION _____

Please indicate well location X.

ADDITIONAL INFORMATION

If more than one screen,
show locations of each on sketch.