

MISSISSIPPI DEPARTMENT OF NATURAL RESOURCES

Bureau of Land and Water Resources

Southport Mall

P.O. Box 10631

Jackson, Mississippi 39209

**CODED**

WATER WELL DRILLERS LOG

*Griner Drilling Service, Inc.*

*Walshall*

*Walshall*  
*A 110*  
*4/1/84*  
*4-1-84*

date well completed

firm name

county well located

LANDOWNER:

description of formations encountered

from

to

*See Land Drilling Co.*  
*900 Dunn St.*  
*Houma, La. 70360*  
(mailing address)

*sand gravel*  
*some clay* **CODED** *0 147*

WELL LOCATION: *990' N + 330' E*

*SAND, gravel* *147 200*

*36 T. 4 N* R. *D. S. SWCOR*  
*No. 1 Heirs*  
*Coil 36-13* *Sunny Hill Field*  
Unit (distance) miles (direction) of (nearest town)

WELL PURPOSE: *oilfield supply*  
(home, irrigation, municipal, industrial)

WELL COMPLETION DATA:

- (1) diameter (inches) *4"*
- (2) total depth (feet) *220'*
- (3) static water level (feet) *50'* **below** above top of ground.
- (4) casing *steel, 189'*  
(material) (depth)  
*4"*  
(size) if telescope see back.
- (5) screen *42', 147'*  
(length) (depth to top)  
*4"*, *perforated*  
(size) (material)
- (6) pump *— 75*  
(HP) (yield gpm)  
*AC*  
(type power)
- (7) electric log *—*  
(yes or no)  
*—*  
(organization running log)

(8) how well bottom plugged *orange peel*

DRILLERS REMARKS:


DEPT. OF NATURAL RESOURCES  
BUREAU OF LAND & WATER RESOURCES

MAY - 7 1984

**RECEIVED**

If well telescopes please sketch and show depths.

GROUND LEVEL

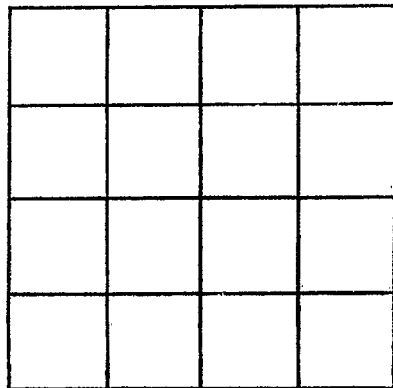

SECTION \_\_\_\_\_

Please indicate well location X.

ADDITIONAL INFORMATION

If more than one screen,  
show locations of each on sketch.