

MISSISSIPPI DEPARTMENT OF NATURAL RESOURCES

Bureau of Land and Water Resources

Southport Mall

P.O. Box 10631

Jackson, Mississippi 39209

WATER WELL DRILLERS LOG

CODED

Griner Drilling Service, Inc.

Walthall

A III
WALTHALL
5-16-84

date well completed

firm name

county well located

5-16-84

LANDOWNER:	description of formations encountered	from	to
David New Drilling P.O. Drawer 1825 Datchez, Ms. 39201 (mailing address)	clay sand, gravel	0	30 315
WELL LOCATION: sec. 26 T. 4 N. R. 10 E 36.12 Manning Crossing miles (direction) of (nearest town) WELL PURPOSE: oilfield bonding (home, irrigation, municipal, industrial)	1650' N + 330' E of SW/4 COR. SIC 31		411 410B
WELL COMPLETION DATA: (1) diameter (inches) 3" (2) total depth (feet) 315' (3) static water level (feet) 60' below top of ground. (4) casing steel 273' (material), (depth) 3" (size) if telescope see back. (5) screen 42' 231' (length), (depth to top) 3" perforated (size), (material) (6) pump - 75-80 (HP), (yield gpm) AC (type power) (7) electric log (yes or no) (organization running log) (8) how well bottom plugged orange peel			
DRILLERS REMARKS:			


DEPT. OF NATURAL RESOURCES
BUREAU OF LAND AND WATER RESOURCES

MAY 21 1984

RECEIVED

If well telescopes please sketch and show depths.

GROUND LEVEL

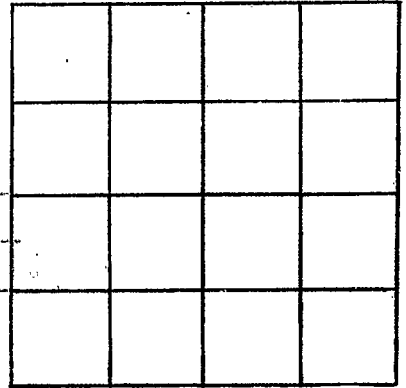

SECTION _____

Please indicate well location X.

ADDITIONAL INFORMATION

If more than one screen, show locations of each on sketch.