

MISSISSIPPI DEPARTMENT OF NATURAL RESOURCES

Bureau of Land and Water Resources

Southport Mall

P.O. Box 10631

Jackson, Mississippi 39209 CODED

WATER WELL DRILLERS LOG

WALTHALL
A 112

10-25-84

Griner Drilling Service, Inc.

Walthall

date well completed

firm name

county well located

LANDOWNER:	description of formations encountered	from	to
See Land Drilling Co 900 Dunn St. Houma, La (mailing address)	sand, gravel, clay	0	100
	sand & gravel	100	294

WELL LOCATION: 330' N + 1010' E
sec. 36 T 40 N R. 10 E SW 1/4
No. 1 Foil
Crosbie Sunny Hill Field
et al (distance) (direction) (nearest town)
36-12

WELL PURPOSE: oil field supply
(home, irrigation, municipal, industrial)

CODED

WELL COMPLETION DATA:

- (1) diameter (inches) 3"
- (2) total depth (feet) 294'
- (3) static water level (feet) 40' below top of ground.
- (4) casing Steel 294'
(material) (depth)
- 3" if telescope see back.
(size)
- (5) screen 42' 252'
(length) (depth to top)
- 3" perforated
(size) (material)
- (6) pump 90
(HP) (yield gpm)
- AC
(type power)
- (7) electric log (yes or no)

(organization running log)

(8) how well bottom plugged orange peel

DEPT. OF NATURAL RESOURCES
BUREAU OF LAND & WATER RESOURCES


NOV 14 1984

RECEIVED

DRILLERS REMARKS:

If well telescopes please
sketch and show depths.

GROUND LEVEL

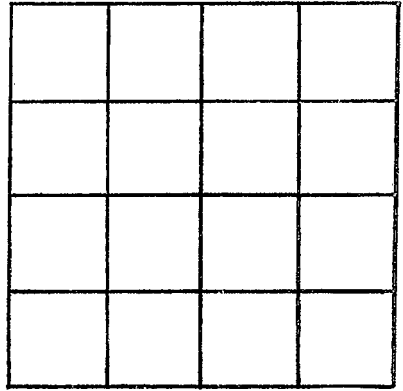

SECTION _____

Please indicate well location X.

ADDITIONAL INFORMATION

If more than one screen,
show locations of each on sketch.