

MISSISSIPPI DEPARTMENT OF NATURAL RESOURCES

Bureau of Land and Water Resources

Southport Mall

P.O. Box 10631

Jackson, Mississippi 39209

WALTHAM
 ①
 A 113

CODED

WATER WELL DRILLERS LOG

1-5-85

Tom Griffith Well Service

Waltham, MS


date well completed

firm name

county well located

LANDOWNER: TEXAS Oil + Gas Suite 555 111 E. CAPITAL St, JACKSON, MS 39201 (mailing address)	description of formations encountered	from	to
	CLAY	0	10
	Sand + Pea Gravel	10	140
WELL LOCATION: sec. 34 T 84 N S R X E W 6 miles SE of Darbon, MS (distance) (direction) (nearest town)	TRI POWER PETROLEUM		
WELL PURPOSE: OIL LOCATION: (home, irrigation, municipal, industrial)	#1 HORN HILL		
WELL COMPLETION DATA: (1) diameter (inches) 3" (2) total depth (feet) 140' (3) static water level (feet) 35' below top of ground. (4) casing PVC, 100' (depth) N/A (size) if telescope see back. (5) screen 40' (length), 100' (depth to top) 3" (size), PVC (material) (6) pump AIR (HP), 10.5 (yield gpm) DIESEL (type power) (7) electric log No (yes or no) NA (organization running log) (8) how well bottom plugged BWV	#1 DINAN		

CODED

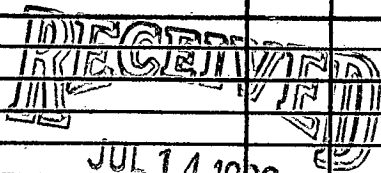

JUL 14 1986

DRILLERS REMARKS:

Department of Natural Resources
 Bureau of Land & Water Resources

If well telescopes please sketch and show depths.

GROUND LEVEL

X			

SECTION 3

Please indicate well location X.

ADDITIONAL INFORMATION

If more than one screen,
show locations of each on sketch.