

MISSISSIPPI DEPARTMENT OF ENVIRONMENTAL QUALITY

Office of Land and Water Resources

P. O. Box 10631
Jackson, MS 39289-0631
WATER WELL DRILLERS LOG

COUNTY WELL LOCATED <i>Walshaw</i>	
WELL NUMBER <i>A-119</i>	CODED
DATE WELL COMPLETED <i>4-15-03</i>	

PERMIT NUMBER
NAME OF DRILLING FIRM <i>Fitzgerald Well Services</i>

NAME & MAILING ADDRESS OF LANDOWNER <i>Marlyn Holmes</i>			
<i>Howell Rd. Tyler-Lan, MS</i>			
Latitude:			
Longitude:			
WELL LOCATION	SEC	TOWNSHIP	RANGE
	<i>13</i>	<i>4 N</i>	<i>9 E</i>
DISTANCE	DIRECTION		NEAREST TOWN
<i>15</i> Miles	<i>North</i>		<i>of Tyler-Lan</i>
OTHER LANDMARK			
WELL PURPOSE: <input checked="" type="radio"/> Home, <input type="radio"/> Irrigation, <input type="radio"/> Municipal, <input type="radio"/> Industrial, <input type="radio"/> Fish Pond, etc.			

PUMP DATA		
PUMP TYPE (Circle One):	Submersible	Turbine, Jet, Flowing Well, Other (Describe)
POWER TYPE (Circle One):	Electric	Tractor, Diesel, Gasoline, Butane, Other (Describe)
DESCRIPTION OF FORMATIONS ENCOUNTERED		
<i>clay</i>	FROM <i>0</i>	TO <i>20</i>
<i>Sandy</i>	<i>20</i>	<i>40</i>
<i>gravel</i>	<i>40</i>	<i>60</i>
<i>clay</i>	<i>60</i>	<i>80</i>
<i>Fine Sand</i>	<i>80</i>	<i>100</i>
<i>clay</i>	<i>100</i>	<i>110</i>
<i>Sandy</i>	<i>110</i>	<i>120</i>
<i>course sand</i>	<i>120</i>	<i>130</i>
RECEIVED MAY 07 2003 BY: OLWR		
Top of Lap Pipe or Reduction in Casing		
FEET	IF TELESCOPED OR MORE THAN ONE SCREEN: USE BACK PAGE	

WELL DATA			
Well Depth	Casing Diameter (In.)	Casing Length (Ft.)	
<i>130'</i>	<i>4"</i>	<i>120'</i>	
Type of Casing	Hole Depth	Depth to Static Water Level	
<i>Pvc</i>	<i>130'</i>	<i>46'</i>	
TYPE OF COMPLETION: (Circle One or More):			
<input checked="" type="checkbox"/> Gravel Packed, <input type="checkbox"/> Underreamed, <input type="checkbox"/> Telescoped, <input type="checkbox"/> Natural Development, <input type="checkbox"/> Open Hole, <input type="checkbox"/> Other (Describe)			
WELL GROUTED TO A DEPTH OF <u><i>10</i></u> FEET			
Type Grout (circle one): Cement, Bentonite, <input checked="" type="checkbox"/> Mix			

SCREEN DATA			
Diameter - Inches	Length - Feet	Slot Size - Inches	
<i>4"</i>	<i>10'</i>	<i>.012</i>	
Screen Type		Depth to Bottom - Feet	
<i>Pvc</i>		<i>130'</i>	

I certify that the well was drilled, constructed and completed in accordance with all applicable Requirements of the Mississippi Department of Environmental Quality and/or the Mississippi Department of Health regulations and state laws.


Beal Fitzgerald
Signature of Licensed Driller and License No. *029*

5-5-03
Date

Additional Information Required On Back

If well telescopes please sketch and show depths.

GROUND LEVEL

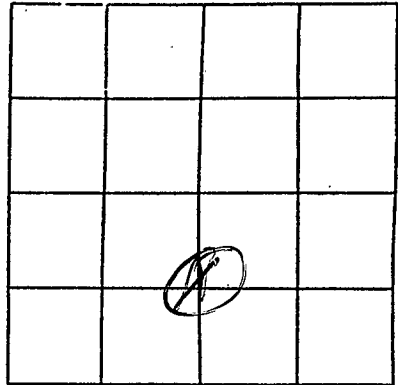

SECTION 13

Please indicate well location X.

Pump Capacity (GPM)	No. of Stages	Setting Depth	
12	8	80	FT.

PUMP TEST

Well yielded _____ GPM with
a drawdown of _____ ft.
after _____ hours of pumping

LOG DATA

TYPE OF LOG RUN (Circle One): No Log Run, Electric, Gamma Ray, Density, Sonic, Neutron, Other (Describe) _____

Name of Organization Running Log _____

GEOLOGIC DATA (Office Use Only)

Surface Elev.	Geologic Unit	Unit Thickness	Depth to Top
Subs. SWL	Date	Analysis	Aquifer Test

Driller's Remarks

If more than one screen, show location of each on sketch.