

WALTHALL MISSISSIPPI BOARD OF WATER COMMISSIONERS

**WATER WELL DRILLERS LOG**

Date Sept 8, 1965, Driller: Chester Lewis County Leflore  
 (Name)

(1) Owner of Land	Description & Color of Materials Sand, Clay, Red Clay, Shell, etc.	Thick- ness Feet	Depth Feet
(Name) <u>John D. Boyd</u> (Address) <u>RFD #1</u>	<u>Red clay</u>	<u>25</u>	<u>35</u>
(2) Location: <u>28 4-10</u> (distance) <u>2</u> miles <u>East</u> of <u>Eastport</u> (direction) (Nearest Town)	<u>fine sand</u> <u>gravel</u>	<u>35</u>	<u>70</u>
(3) Topography: <u>Hilly</u> (Hilly) (Flat) (Level)	<u>Coarse sand</u> <u>&amp; gravel</u>	<u>25</u>	<u>105</u>
(4) Purpose of Well: <u>Domestic</u> (Domestic Irrigation Municipal, Industrial, Other)			<u>17122</u>


Information upon completion of well:

- (1) Diameter 4 inches.
- (2) Total Depth 122 feet.
- (3) Water Level 75 feet below top of ground.
- (4) Cased to bottom size 4
- (5) Screen: Size 4", Length 7'
- (6) Were any formations sealed against pollution?  
 yes,  no.

If YES depth of formation \_\_\_\_\_

Why \_\_\_\_\_

Drillers Remarks: well had

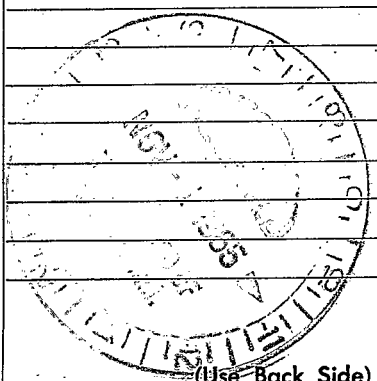

(Use Back Side)

Well No.

