

Walthall
 A 200
 12-13-68

MISSISSIPPI
 BOARD OF WATER COMMISSIONERS
 416 North State Street
 Jackson, Mississippi 39201

CODING
 CODING

WATER WELL DRILLERS LOG

12-13 19 68 Fritz G. Stahlman Walthall
 date well completed firm name county well located

LANDOWNER: Eron Baptist Church

description of formations encountered	from to	
Red clay	0	20
Red sand	20	60
Coarse sand & gravel	60	75
Red sand	75	96
Coarse sand & gravel	96	112

Rt 1 Joplin, Miss.
 (mailing address)

WELL LOCATION:

sec. 30 T 4 N R 10 E
 S W
 1 N miles of Eron
 (distance) (direction) (nearest town)

WELL PURPOSE: home
 (home, irrigation, municipal, industrial)

WELL COMPLETION DATA:

- (1) diameter (inches) 4
- (2) total depth (feet) 112
- (3) static water level (feet) 25 below top of ground.
- (4) casing Plastic 106'
 (material) (depth)
 4 (size) if telescope see back.
- (5) screen 6' 106'
 (length) (depth to top)
 4" Plastic
 (size) (material)
- (6) pump ? ?
 (HP) (yield gpm)
 Elec
 (type power)
- (7) electric log No
 (yes or no)
 (organization running log)
- (8) how well bottom plugged Good plug


DRILLERS REMARKS:

JAN 2 1968

MISS. BD. OF
 WATER WORKS

If well telescopes please sketch and show depths.

GROUND LEVEL

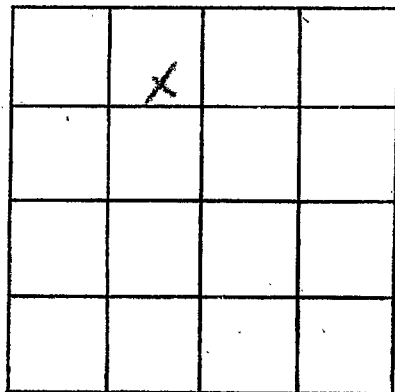

SECTION 20

Please indicate well location X.

ADDITIONAL INFORMATION

If more than one screen,
show locations of each on sketch.