

Walthall  
 A 2002  
 8/75

MISSISSIPPI  
 BOARD OF WATER COMMISSIONERS  
 416 North State Street  
 Jackson, Mississippi 39201


WATER WELL DRILLERS LOG

August 25 1975 E. B. Sherrard Walthall  
 date well completed firm name county well located

LANDOWNER:	description of formations encountered	from	to
Celest Brown Dykestown, MS. (mailing address)	RED LOOSE SANDY CLAY GRAVEL & SAND	0 60'	60' 9.5'
WELL LOCATION: sec 27 T 4 N R 10 E 132 11 miles NNW of Dykestown (distance) (direction) (nearest town)			
WELL PURPOSE: (home) irrigation, municipal, industrial			
WELL COMPLETION DATA: (1) diameter (inches) 2" (2) total depth (feet) 95' (3) static water level (feet) 60' below top of ground. (4) casing pl. 90' (material) (depth) 2" (size) if telescope see back. (5) screen 5' (length) (depth to top) 2" (size) pl. (material) (6) pump 1 (HP) 7 (yield gpm) E (type power) (7) electric log (yes or no) (organization running log) (8) how well bottom plugged BHW			
DRILLERS REMARKS:	RECEIVED DEC 5 1975 MISS. BD. OF WATER COMMISSIONERS		

If well telescopes please sketch and show depths.

GROUND LEVEL

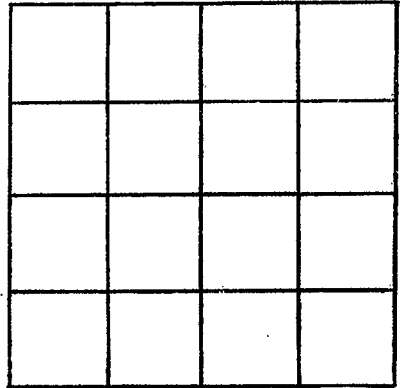

SECTION \_\_\_\_\_

Please indicate well location X.

ADDITIONAL INFORMATION

If more than one screen, show locations of each on sketch.