

WALTHALL  
 A 2003  
 9-29-75

MISSISSIPPI  
 BOARD OF WATER COMMISSIONERS  
 416 North State Street  
 Jackson, Mississippi 39201  
 Renewed Service  
 WATER WELL DRILLERS LOG


Sept-29 1975 ~~Mississippi State~~ Walthall  
 date well completed firm name county well located

LANDOWNER:	description of formations encountered	from	to
Mrs. Gertrude Cade Rt. Tipton (mailing address)			
WELL LOCATION: sec. 29 T 4 N R 10 E 12 miles N-W of Tipton (distance) (direction) (nearest town)			
WELL PURPOSE: Home (home, irrigation, municipal, industrial)			
WELL COMPLETION DATA:			
(1) diameter (inches) 4"			
(2) total depth (feet) 121			
(3) static water level (feet) 90 below top of ground			
(4) casing <u>plastic</u> bottom (material) (depth)			
<u>1</u> if telescope see back. (size)			
(5) screen <u>6"</u> <u>115</u> (length) (depth to top)			
<u>4"</u> <u>plastic</u> (size) (material)			
(6) pump <u>1/2</u> <u>10</u> (HP) (yield gpm)			
(type power)			
(7) electric log <u>no</u> (yes or no)			
(organization running log)			
(8) how well bottom plugged <u>no casing plug</u>			
DRILLERS REMARKS: <u>Red pump went bad</u>			

JAN 12 1976  
 MISSISSIPPI  
 BOARD OF WATER COMMISSIONERS

If well tele-logs please sketch and show depths.

GROUND LEVEL

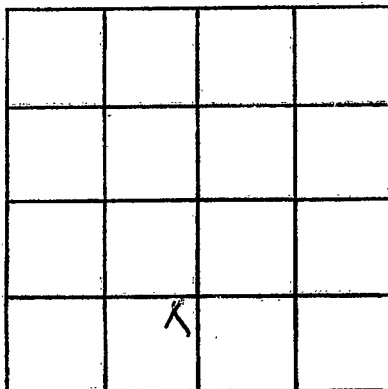

SECTION 29

Please indicate well location X.

ADDITIONAL INFORMATION

If more than one screen, show locations of each on sketch.