

Walthall

A 2004

11-26-75

MISSISSIPPI
 BOARD OF WATER COMMISSIONERS
 416 North State Street
 Jackson, Mississippi 39201

WATER WELL DRILLERS LOG

11-26 1975
date well completed

Fitzgerald Well Serv
firm name

Walthall
county well located

LANDOWNER:

Doris Jenkins

R.R. Myers, Mrs.
(mailing address)

description of formations encountered

from to

Red clay

0 20

Red sand

20 70

Coarse sand & gravel

70 100

WELL LOCATION:

sec. 8 T. 4 N R. 10 E
S W

1 miles N of Enoch
(distance) (direction) (nearest town)

WELL PURPOSE: Home
(home, irrigation, municipal, industrial)

WELL COMPLETION DATA:

- (1) diameter (inches) 4
- (2) total depth (feet) 100
- (3) static water level (feet) 70 below top of ground.

(4) casing plastic, 92
(material) (depth)

4 If telescope see back.
(size)

(5) screen 8, 92
(length) (depth to top)

4, PVC
(size) (material)

(6) pump 1/2, 10
(HP) (yield gpm)

Electric
(type power)

(7) electric log No
(yes or no)

(organization running log)

(8) how well bottom plugged Sand shank


DRILLERS REMARKS:

DEC 17 1975

MISS. BD. OF WATER COMM

If well telescopes please sketch and show depths.

GROUND LEVEL

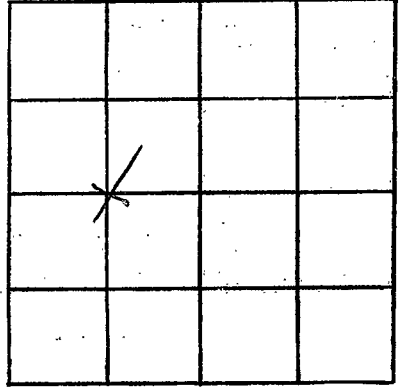

SECTION 8

Please indicate well location X.

ADDITIONAL INFORMATION

If more than one screen, show locations of each on sketch.