

Walshall  
A 2005  
7/29/76

MISSISSIPPI  
 BOARD OF WATER COMMISSIONERS  
 416 North State Street  
 Jackson, Mississippi 39201

WATER WELL DRILLERS LOG

July 29 1976 Reena Well Co Walshall  
 date well completed firm name county well located

LANDOWNER:  
Miss Belinda Boyd  
P.O. Jays  
 (mailing address)

description of formations encountered	from	to
<u>Red clay</u>	<u>0</u>	<u>22</u>
<u>Red sand</u>	<u>22</u>	<u>105</u>
<u>small gravel sand</u>	<u>105</u>	<u>117</u>

WELL LOCATION:  
 sec. 5 T 4 N R 10 E  
2 1/2 miles north of Enon  
 (distance) (direction) (nearest town)

WELL PURPOSE: Trailer  
 (home, irrigation, municipal, industrial)

WELL COMPLETION DATA:  
 (1) diameter (inches) 4"  
 (2) total depth (feet) 117  
 (3) static water level (feet) 68 below above top of ground.  
 (4) casing plastic bottom  
 (material) (depth)  
 (size) If telescope see back.  
 (5) screen 6' 111  
 (length) (depth to top)  
4" plastic  
 (size) (material)  
 (6) pump 1/2 Sub 10  
 (HP) (yield gpm)  
electric  
 (type power)  
 (7) electric log NO  
 (yes or no)  
 (organization running log)

(8) how well bottom plugged  
Washed plug  
 DRILLERS REMARKS:


**RECEIVED**

OCT 26 1976

MISS. BD. OF WATER COMMISSIONERS

If well telescopes please  
sketch and show depths.

GROUND LEVEL

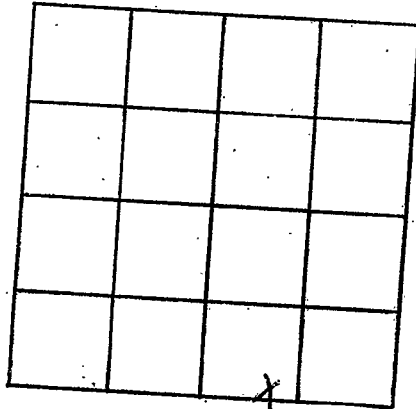

SECTION 5

Please indicate well location. X.

ADDITIONAL INFORMATION

If more than one screen,  
show locations of each on sketch.