

Walworth  
A 2000  
7/27/76

MISSISSIPPI  
 BOARD OF WATER COMMISSIONERS  
 416 North State Street  
 Jackson, Mississippi 39201

WATER WELL DRILLERS LOG

Walworth

77564 1974 J.T. Conroy & Co. Walworth  
 date well completed firm name county well located

LANDOWNER:  
Clinton Johnson  
Summit  
 (mailing address)

description of formations encountered	from	to
<u>Clay</u>	<u>0</u>	<u>25</u>
<u>Sand</u>	<u>25</u>	<u>60</u>
<u>Chalk</u>	<u>60</u>	<u>85</u>
<u>Sand</u>	<u>85</u>	<u>114</u>

WELL LOCATION:  
 sec. 13 T. 4 N R. 10 E  
10 miles NE of McCall  
 (distance) (direction) (nearest town)

WELL PURPOSE:  
 (home, irrigation, municipal, industrial)


- WELL COMPLETION DATA:
- (1) diameter (inches) 4
  - (2) total depth (feet) 114
  - (3) static water level (feet) 90 below above top of ground.
  - (4) casing PI 103  
 (material) (depth)  
 (size) if telescope see back.
  - (5) screen 6 103  
 (length) (depth to top)  
4 PI  
 (size) (material)
  - (6) pump 1/2 8  
 (HP) (yield gpm)  
glut  
 (type power)
  - (7) electric log (yes or no)
  - (organization running log)
  - (8) how well bottom plugged good

DRILLERS REMARKS:

**RECEIVED**  
 SEP - 1 1976  
 MISS. BD. OF WATER COMM.

If well telescopes please sketch and show depths.

GROUND LEVEL

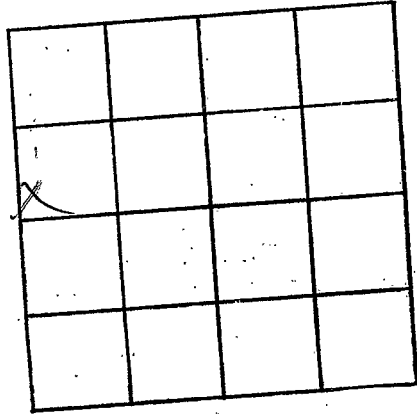

SECTION 13

Please indicate well location X.

ADDITIONAL INFORMATION

If more than one screen, show locations of each on sketch.