

WALTHALL
A 2008
4-24-76

MISSISSIPPI
BOARD OF WATER COMMISSIONERS
 416 North State Street
 Jackson, Mississippi 39201

WATER WELL DRILLERS LOG

April 24 1976 Rever Well Service Walthall
 date well completed firm name county well located

LANDOWNER:
Billy Boyd
 (mailing address)

description of formations encountered	from	to
<u>clay</u>	<u>0</u>	<u>20</u>
<u>red chalky sand</u>	<u>20</u>	<u>100</u>
<u>small gravel</u>	<u>100</u>	<u>115</u>

WELL LOCATION:
 sec 26 T 4 N R 10 E
11 miles north of Jackson
 (distance) (direction) (nearest town)

WELL PURPOSE: Trailer
 (home, irrigation, municipal, industrial)


- WELL COMPLETION DATA:**
- (1) diameter (inches) 4"
 - (2) total depth (feet) 115
 - (3) static water level (feet) 75 below top of ground.
 - (4) casing plastic bottom
 (material) (depth)
 - (size) If telescope see back.
 - (5) screen 6" 109
 (length) (depth to top)
 - 4" plastic
 (size) (material)
 - (6) pump 1/2 10
 (HP) (yield gpm)
 - elect
 (type power)
 - (7) electric log no
 (yes or no)
 - (organization running log)

(8) how well bottom plugged wooden plug
DRILLERS REMARKS:
no remark.

RECEIVED
 APR - 8 1976

If well telescopes please sketch and show depths.

GROUND LEVEL

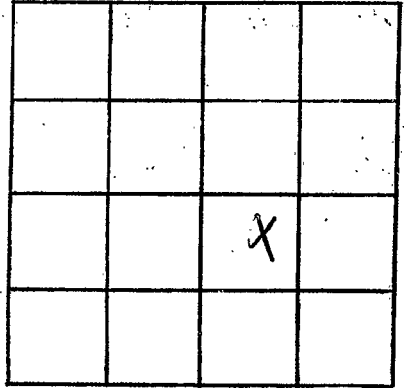

SECTION 26

Please indicate well location X.

ADDITIONAL INFORMATION

If more than one screen, show locations of each on sketch.