

WALTHALL

A 2009

4-1-76

MISSISSIPPI BOARD OF WATER COMMISSIONERS  
416 North State Street  
Jackson, Mississippi 39201

WATER WELL DRILLERS LOG

April 1 1976  
date well completed


132  
Peeves Well Service Walthall  
firm name county well located

LANDOWNER:	description of formations encountered	from	to
Miss Marie Mess Rt 3 Syletown (mailing address)	Clay gravel sand pink chalk sand & gravel cobble sea gravel & sand	0 30 45 60 80	30 45 60 80 106
WELL LOCATION: sec 36 T 4 N R 10 E 12 miles N. N. W. of Syletown (distance) (direction) (nearest town)			
WELL PURPOSE: Irrigation (home, irrigation, municipal, industrial)			
WELL COMPLETION DATA:			
(1) diameter (inches) 4"			
(2) total depth (feet) 106			
(3) static water level (feet) 45 Below top of ground.			
(4) casing plastic bottom (material) (depth)			
(5) screen 6' 100 (length) (depth to top)			
4" plastic (size) (material)			
(6) pump 1/2 HP 10 (HP) (yield gpm)			
shot (type power)			
(7) electric log no (yes or no)			
(organization running log)			
(8) how well bottom plugged wooden plug			
DRILLERS REMARKS: no Remark			

JUN 9 1976  
MISS. BD. OF WATER

If well telescopes please sketch and show depths.

GROUND LEVEL

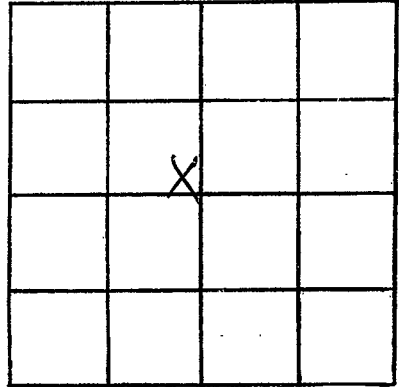

SECTION 36

Please indicate well location X.

ADDITIONAL INFORMATION

If more than one screen, show locations of each on sketch.