

WALTHALL
A 2010
2-27-76

MISSISSIPPI
 BOARD OF WATER COMMISSIONERS
 416 North State Street
 Jackson, Mississippi 39201

WATER WELL DRILLERS LOG

Walthall
Miss

2-27 1976
 date well completed

Craver - Cinn
 firm name


county well located

LANDOWNER:	description of formations encountered	from	to
<u>Frank Slipher</u> <u>1306 Bill Columbus</u> (mailing address) <u>Miss</u>			
<p>WELL LOCATION:</p> <p>sec. <u>25</u> T <u>4</u> N. R <u>10</u> E. S <u>1</u> E</p> <p><u>13</u> miles <u>NW</u> of <u>Yalobee</u> (distance) (direction) (nearest town)</p> <p>WELL PURPOSE: <u>Domestic</u> (home, irrigation, municipal, industrial)</p> <p>WELL COMPLETION DATA:</p> <p>(1) diameter (inches) <u>2"</u></p> <p>(2) total depth (feet) <u>220</u></p> <p>(3) static water level (feet) <u>80</u> below top of ground.</p> <p>(4) casing <u>PVC</u>, <u>210</u>, (material) (depth) <u>2"</u> if telescope see back. (size)</p> <p>(5) screen <u>10'</u>, <u>210</u> (length) (depth to top) <u>2"</u>, <u>P.V.C.</u> (size) (material)</p> <p>(6) pump <u>2</u>, <u>11</u> (HP) (yield gpm) <u>elec.</u> (type power)</p> <p>(7) electric log <u>NO</u> (yes or no)</p> <p>(organization running log)</p> <p>(8) how well bottom plugged <u>B.W. valve</u></p>			
DRILLERS REMARKS:			

MISS. BOARD OF WATER COMMISSIONERS
 MAR 29 1976

If well telescopes please sketch and show depths.

GROUND LEVEL

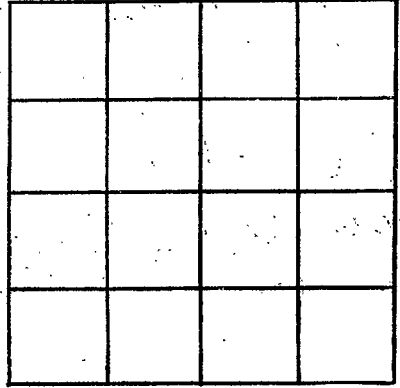

SECTION _____

Please indicate well location X.

ADDITIONAL INFORMATION

If more than one screen, show locations of each on sketch.