

Walthall
 A 2011
 3/3/76

MISSISSIPPI
 BOARD OF WATER COMMISSIONERS
 416 North State Street
 Jackson, Mississippi 39201

WATER WELL DRILLERS LOG

March 3 1976 Renew Well Service Walthall
 date well completed firm name county well located

LANDOWNER:
 Odell Mr Kenzie
 A.F.P. Tylertown
 (mailing address)

description of formations encountered	from	to
Red clay	0	15
Red sand	15	40
gravel & sand	40	75
pink chalk	75	107
hard granular	107	132

WELL LOCATION:
 sec. 29 T 4 N R 10 E
 1 3/4 miles South of Tylertown
 (distance) (direction) (nearest town)

WELL PURPOSE: home
 (home, irrigation, municipal, industrial)


WELL COMPLETION DATA:
 (1) diameter (inches) 4"
 (2) total depth (feet) 132
 (3) static water level (feet) 80 below top of ground
 (4) casing Plastic bottom (material) (depth)
 (5) screen 6 (length) 126 (depth to top)
 4" (size) plastic (material)
 (6) pump 1/2 (HP) 18 (yield gpm)
 elect (type power)
 (7) electric log no (yes or no)
 (organization running log)

(8) how well bottom plugged
 wooden plug
 DRILLERS REMARKS:
 no remarks

MISS. BD. OF WATER COMMISSIONERS
 6 1976

If well telescopes please sketch and show depths.

GROUND LEVEL

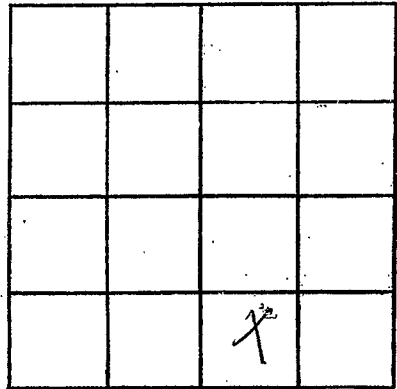

SECTION 29

Please indicate well location X.

ADDITIONAL INFORMATION

If more than one screen,
show locations of each on sketch.