

WALTHALL
A 202
12/7/77

MISSISSIPPI
BOARD OF WATER COMMISSIONERS
416 North State Street
Jackson, Mississippi 39201

WATER WELL DRILLERS LOG

Dec. 7 1977 Brownfield Well Serv WALTHALL
date well completed firm name county well located

LANDOWNER: R.T. Conery
Tyler town
Miss
(mailing address)

description of formations encountered	from	to
<u>CLAY</u>	<u>0</u>	<u>16</u>
<u>SANDY CLAY</u>	<u>16</u>	<u>28</u>
<u>WET CLAY</u>	<u>28</u>	<u>79</u>
<u>SAND + CLAY</u>	<u>79</u>	<u>105</u>
<u>ROCK + SAND</u>	<u>105</u>	<u>120</u>

WELL LOCATION:
sec. 24 T. 4 N. R. 10 E
12 miles N of Tyler town
(distance) (direction) (nearest town)

WELL PURPOSE: IND. USE
(home, irrigation, municipal, industrial)

WELL COMPLETION DATA:
(1) diameter (inches) 4"
(2) total depth (feet) 120
(3) static water level (feet) 79 below top of ground.
(4) casing PASTE 110
(material) (depth)
4" if telescope see back.
(size)
(5) screen 16' 110
(length) (depth to top)
4 PASTIC
(size) (material)
(6) pump 1/2 8
(HP) (yield gpm)
electric
(type power)
(7) electric log no
(yes or no)

(organization running log)
(8) how well bottom plugged Sand Shale

DRILLERS REMARKS:


RECEIVED

MAR 21 1978

MISS. Bd. OF WATER COMM.

If well telescopes please sketch and show depths.

GROUND LEVEL

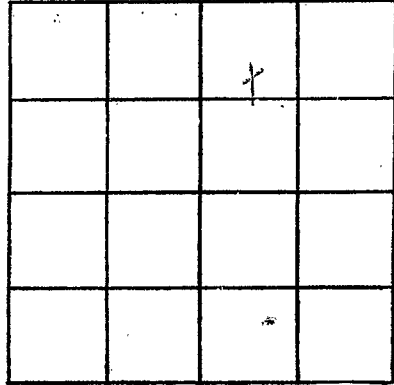

SECTION 24

Please indicate well location X.

ADDITIONAL INFORMATION

If more than one screen, show locations of each on sketch.