

WALTHALL
A 2053
9/9/77

MISSISSIPPI
BOARD OF WATER COMMISSIONERS
416 North State Street
Jackson, Mississippi 39201

(119)

WATER WELL DRILLERS LOG

9-9-77 date well completed
27 Renew Well Co firm name
Walthall county well located

LANDOWNER:
D-E Burnette
At 3 Jayess
(mailing address)

WELL LOCATION:
sec. 31 T-4 N R-10 E
11 miles N-NW of Tylertown
(distance) (direction) (nearest town)

WELL PURPOSE: Home
(home, irrigation, municipal, industrial)

WELL COMPLETION DATA:
(1) diameter (inches) 4"
(2) total depth (feet) 111'
(3) static water level (feet) 80 below top of ground.
(4) casing plastic, bottom (material) (depth)
If telescope see back.
(5) screen 5' 106" (length) (depth to top)
4" plastic (size) (material)
(6) pump 1/2 hp 10 (HP) (yield gpm)
elect (type power)
(7) electric log no (yes or no)
(organization running log)

(8) how well bottom plugged
welder plug


DRILLERS REMARKS:
old well bad

description of formations encountered	from	to
Clay	0	12
Red Sand	12	65
fine sand gravel	65	90
pebbly chalk	90	95
Gravel & sand	95	111

RECEIVED
FEB 21 1978

If well telescopes please
sketch and show depths.

GROUND LEVEL

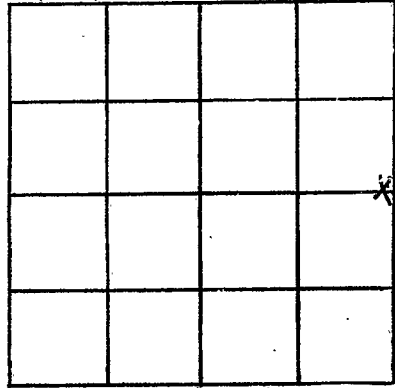

SECTION 31

Please indicate well location X.

ADDITIONAL INFORMATION

If more than one screen,
show locations of each on sketch.