

Walthall  
 A 2014  
 8/19/77

MISSISSIPPI  
 BOARD OF WATER COMMISSIONERS  
 416 North State Street  
 Jackson, Mississippi 39201

109

WATER WELL DRILLERS LOG

Aug 19 1977 Reems Wellser Walthall  
 date well completed firm name county well located

LANDOWNER:  
 Kelly Jefferson  
 Rt 3 Jollyess  
 (mailing address)

description of formations encountered	from	to
Red Clay	0	22
Red sand	22	105
gravel sand	105	120

WELL LOCATION:  
 sec. 14 T. 4 N R. 10 E  
 4 miles West of Sartonville  
 (distance) (direction) (nearest town)

WELL PURPOSE: home  
 (home, irrigation, municipal, industrial)

- WELL COMPLETION DATA:
- (1) diameter (inches) 4"
  - (2) total depth (feet) 120
  - (3) static water level (feet) 86.2 below top of ground
  - (4) casing plastic bottom (material) (depth)
  - (size) if telescope see back.
  - (5) screen 5' 11.5" (length) (depth to top)  
 4" plastic (size) (material)
  - (6) pump 1/2 HP 10 (HP) (field gpm)  
 elect (type power)
  - (7) electric log no (yes or no)
  - (organization running log)

(8) how well bottom plugged  
 Wooden Plug


DRILLERS REMARKS:  
 none

RECEIVED  
 DEC 30 1977

MISS. BD. OF WATER COMMISSIONERS

If well telescopes please sketch and show depths.

GROUND LEVEL

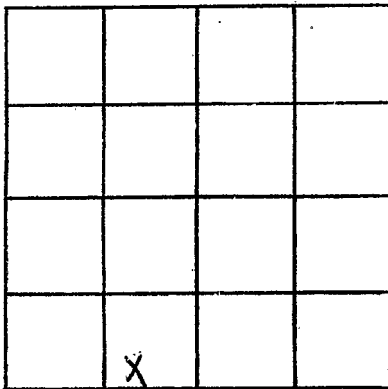

SECTION 14

Please indicate well location X.

ADDITIONAL INFORMATION

If more than one screen, show locations of each on sketch.