

Walthall  
A 2015  
8/10/77

MISSISSIPPI  
BOARD OF WATER COMMISSIONERS  
416 North State Street  
Jackson, Mississippi 39201

103

WATER WELL DRILLERS LOG

Aug 10 1977 Brenniss Miller Walthall  
date well completed firm name county well located

LANDOWNER:  
Brenniss Davis  
Rt 1 Jayson  
(mailing address)

description of formations encountered	from	to
<u>Red Sandstone Clay</u>	<u>0</u>	<u>23</u>
<u>Red Sandstone</u>	<u>23</u>	<u>88</u>
<u>small gravelly sand</u>	<u>88</u>	<u>102</u>

WELL LOCATION:  
sec. 12 T 4 N R 10 E  
S W  
2 miles west of Sartorisville  
(distance) (direction) (nearest town)

WELL PURPOSE: home  
(home, irrigation, municipal, industrial)

WELL COMPLETION DATA:  
(1) diameter (inches) 4"  
(2) total depth (feet) 102  
(3) static water level (feet) 60 below above top of ground  
(4) casing plastic bottom  
(material) (depth)  
(size) if telescope see back.  
(5) screen 5' 99'  
(length) (depth to top)  
4' plastic  
(size) (material)  
(6) pump 1/2 hp 40  
(HP) (yield gpm)  
1/2 hp  
(type power)  
(7) electric log no  
(yes or no)  
(organization running log)


(8) how well bottom plugged  
plastic plug  
DRILLERS REMARKS:  
[Signature]

RECEIVED  
DEC 30 1977

MISS. BD. OF WATER COMM

If well telescopes please sketch and show depths.

GROUND LEVEL

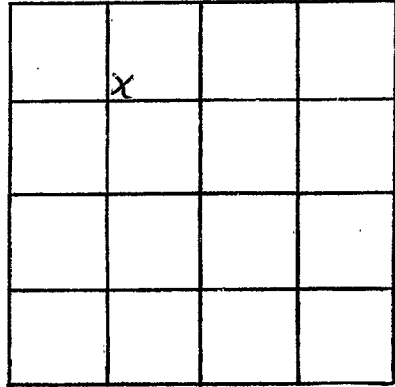

SECTION 12

Please indicate well location X.

ADDITIONAL INFORMATION

If more than one screen,  
show locations of each on sketch.