

WALTHALL
A 2016
8-2-77

MISSISSIPPI
BOARD OF WATER COMMISSIONERS
416 North State Street
Jackson, Mississippi 39201

WATER WELL DRILLERS LOG

8-2 1977 *Fitzgerald Well Serv* *Walthall*
date well completed firm name county well located


LANDOWNER:	description of formations encountered	from	to
<i>Coy Thomas</i>			
<i>R.R. Jones, Inc.</i> (mailing address)	<i>Red clay</i> <i>Red sand</i> <i>Coarse sand & gravel</i>	<i>0</i> <i>20</i> <i>80</i>	<i>20</i> <i>80</i> <i>100</i>
WELL LOCATION:			
sec. <i>24</i> T <i>4</i> N R <i>10</i> E S W			
<i>2</i> miles <i>E</i> of <i>Pineblake</i> (distance) (direction) (nearest town)			
WELL PURPOSE: <i>Home</i> (home, irrigation, municipal, industrial)			
WELL COMPLETION DATA:			
(1) diameter (inches) <i>4</i>			
(2) total depth (feet) <i>100</i>			
(3) static water level (feet) <i>70</i> below above top of ground.			
(4) casing <i>PVC</i> <i>92</i> (material) (depth)			
<i>4</i> (size) If telescope see back.			
(5) screen <i>8</i> <i>92</i> (length) (depth to top)			
<i>4</i> <i>PVC</i> (size) (material)			
(6) pump <i>1/2</i> <i>10</i> (HP) (yield gpm)			
<i>Electric</i> (type power)			
(7) electric log <i>no</i> (yes or no)			
(organization running log)			
(8) how well bottom plugged <i>Sand block</i>			
DRILLERS REMARKS:			

RECEIVED
AUG 23 1977

MISSISSIPPI BOARD OF WATER COMMISSIONERS

If well telescopes please
sketch and show depths.

GROUND LEVEL

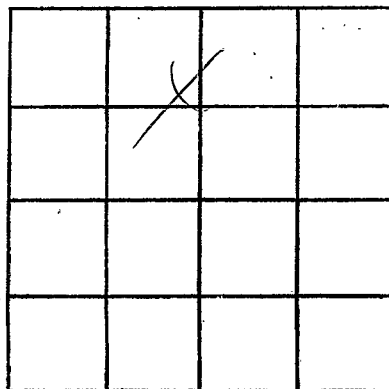

SECTION 24

Please indicate well location X.

ADDITIONAL INFORMATION

If more than one screen,
show locations of each on sketch.