

WALTHALL

A 207

6-22-77

MISSISSIPPI BOARD OF WATER COMMISSIONERS
416 North State Street
Jackson, Mississippi 39201

WATER WELL DRILLERS LOG

6-22 date well completed

19 77 Fitzgerald & Sons firm name

Walthall county well located

LANDOWNER:

Alison Howell

POB [unclear] (mailing address)

description of formations encountered

from

to

Red clay

0 20

Red sand

20 80

Coarse sand & gravel

80 110

WELL LOCATION:

sec. 24 T. 4 N. R. 10 E. S. W.
2 miles (distance) 20 E (direction) of Riceland (nearest town)

WELL PURPOSE:

(home, irrigation, municipal, industrial) Home

WELL COMPLETION DATA:

- (1) diameter (inches) 4
- (2) total depth (feet) 160
- (3) static water level (feet) 80 below above top of ground.
- (4) casing PVC, 102, (material), (depth), 4 (size) if telescope see back.
- (5) screen 8 (length), 102 (depth to top), 4 (size), PVC (material)
- (6) pump 1/2 (HP), 10 (yield gpm), elec (type power)
- (7) electric log (yes or no) No (organization running log)
- (8) how well bottom plugged Sand block


RECEIVED
AUG 29 1977

DRILLERS REMARKS:

MISS. BD. OF WATER COMMISSIONERS

If well telescopes please sketch and show depths.

GROUND LEVEL

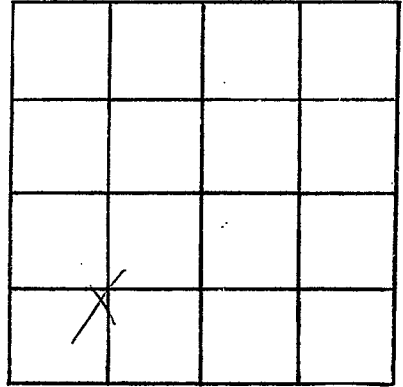

SECTION 24

Please indicate well location X.

ADDITIONAL INFORMATION

If more than one screen,
show locations of each on sketch.