

68

WALTHALL
A 2018
6-16-77

MISSISSIPPI
BOARD OF WATER COMMISSIONERS.
416 North State Street
132 Jackson, Mississippi 39201

WATER WELL DRILLERS LOG

June 16 1977 Reems Miller Walthall
date well completed firm name county well located

LANDOWNER:
Gene Reid
Rt. Jopetown
(mailing address)

description of formations encountered	from	to
<u>Clay</u>	<u>0</u>	<u>12</u>
<u>Red sand</u>	<u>12</u>	<u>25</u>
<u>Red Chalk</u>	<u>25</u>	<u>50</u>
<u>Chalky sand</u>	<u>50</u>	<u>96</u>
<u>Sand & pea gravel</u>	<u>96</u>	<u>120</u>

WELL LOCATION:
sec. 9 T. 4 N R. 10E
2 1/2 miles N-NE of EVEN
(distance) (direction) (nearest town)

WELL PURPOSE: Trerloc
(home, irrigation, municipal, industrial)

- WELL COMPLETION DATA:
- (1) diameter (inches) 4
 - (2) total depth (feet) 120
 - (3) static water level (feet) 65 below above top of ground.
 - (4) casing plastic, bottom
(material) (depth)
 - 1 if telescope see back.
(size)
 - (5) screen 6" 114'
(length) (depth to top)
 - 1/2" plastic
(size) (material)
 - (6) pump 1/2 10
(HP) (yield gpm)
 - elect
(type power)
 - (7) electric log no
(yes or no)
 - (organization running log)


(8) how well bottom plugged
wooden plug
DRILLERS REMARKS:
new location

RECEIVED

NOV - 9 1977

If well telescopes please sketch and show depths.

GROUND LEVEL

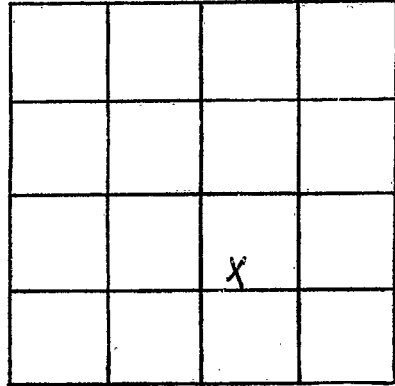

SECTION 9

Please indicate well location X.

ADDITIONAL INFORMATION

If more than one screen,
show locations of each on sketch.