

WALTHALL
A 208
2/16/77

MISSISSIPPI
BOARD OF WATER COMMISSIONERS
416 North State Street
Jackson, Mississippi 39201

WATER WELL DRILLERS LOG

Feb. 16 1977 Beautiful Well Serv. WALTHALL
date well completed firm name county well located

LANDOWNER: JACKSON
JR MISS
(mailing address)

WELL LOCATION:
sec. 12 T. 4 N. R. 10 E
2 1/2 miles W of Sartineville
(distance) (direction) (nearest town)

WELL PURPOSE: Home
(home, irrigation, municipal, industrial)

- WELL COMPLETION DATA:
- (1) diameter (inches) 4"
 - (2) total depth (feet) 91'
 - (3) static water level (feet) 77' below above top of ground.
 - (4) casing Plastic 81'
(material) (depth)
4" if telescope see back.
(size)
 - (5) screen 10' 81'
(length) (depth to top)
4" Plastic
(size) (material)
 - (6) pump 1/2 8
(HP) (yield gpm)
Electric
(type power)
 - (7) electric log no
(yes or no)

(organization running log)
(8) how well bottom plugged Sand Shank

description of formations encountered	from	to
CLAY	0	12
SAND	12	57
SAND + GRAVEL	57	65
CHALK	65	73
SAND	73	78
SAND + ROCK	78	91


DRILLERS REMARKS:

RECEIVED

MAR 21 1978

If well telescopes please sketch and show depths.

GROUND LEVEL

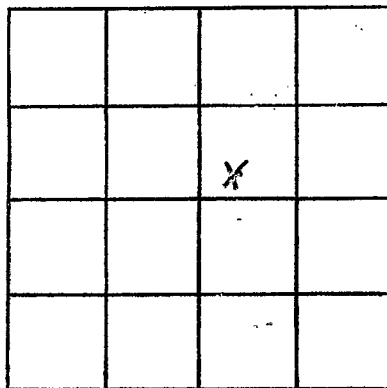

SECTION 12

Please indicate well location X.

ADDITIONAL INFORMATION

If more than one screen,
show locations of each on sketch.