

WALTHALL
A 2000
2-25-77

MISSISSIPPI
 BOARD OF WATER COMMISSIONERS
 416 North State Street
 1326 Jackson, Mississippi 39201

WATER WELL DRILLERS LOG

2-25 19 77 *F. St. Paul & Co. Inc.* *Walthall*
 date well completed firm name county well located

LANDOWNER:

Elsie Denaway

R.R. Jayess, Miss.
 (mailing address)

description of formations encountered

from to

<i>Red clay</i>	<i>0</i>	<i>20</i>
<i>Red sand</i>	<i>20</i>	<i>70</i>
<i>Coarse level gravel</i>	<i>70</i>	<i>85</i>

WELL LOCATION:

sec. *24* T. *4* N. R. *10* E
S *W*
2 1/2 miles *E* of *Prichard*
 (distance) (direction) (nearest town)

WELL PURPOSE:

Home
 (home, irrigation, municipal, industrial)

WELL COMPLETION DATA:

- (1) diameter (inches) *4*
- (2) total depth (feet) *85*
- (3) static water level (feet) *50* below above top of ground.
- (4) casing *PVC*, *77*,
 (material) (depth)
4 if telescope see back.
 (size)
- (5) screen *8*, *77*
 (length) (depth to top)
4, *PVC*
 (size) (material)
- (6) pump *1/2*, *10*
 (HP) (yield gpm)
Electric
 (type power)
- (7) electric log *No*
 (yes or no)
 (organization running log)
- (8) how well bottom plugged *Sand blk*


DRILLERS REMARKS:

RECEIVED
 MAR 30 1977

MISS. Bd. OF WATER COMMISSIONERS

If well telescopes please sketch and show depths.

GROUND LEVEL

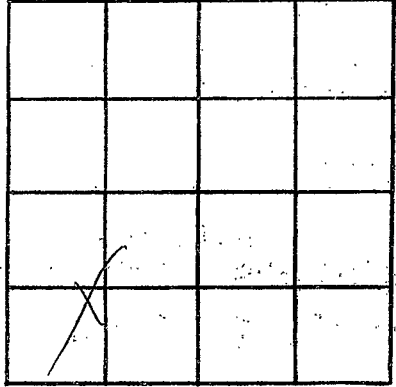

SECTION 24

Please indicate well location X.

ADDITIONAL INFORMATION

If more than one screen, show locations of each on sketch.