

WALTHALL
A 2221
2-15-77

MISSISSIPPI
BOARD OF WATER COMMISSIONERS
416 North State Street
1324 Jackson, Mississippi 39201

(14)

WATER WELL DRILLERS LOG

Feb 15
date well completed

1977 Renewwell Service
firm name

Walthall
county well located

LANDOWNER:
Jocoy Seago
Rt 3 Tipton
(mailing address)

description of formations encountered	from	to
Red Clay	0	22
Red sand	22	60
Red Chalk	60	83
Gravel & Chalk	83	120
Coarse sand	120	143

WELL LOCATION:
sec. 18 T 4 N R 10 E
1 miles S WNW of Cron
(distance) (direction) (nearest town)

WELL PURPOSE: none
(home, irrigation, municipal, industrial)

- WELL COMPLETION DATA:
- (1) diameter (inches) 12"
 - (2) total depth (feet) 143
 - (3) static water level (feet) 90 below top of ground
 - (4) casing plastic, bottom (material) (depth)
 - (5) screen 5' bottom (length) (depth to top)
 - 4" plastic (size) (material)
 - (6) pump 1/2 HP 10 (HP) (yield gpm)
 - split (type power)
 - (7) electric log no (yes or no)
 - (organization running log)


(8) how well bottom plugged
wooden plug

DRILLERS REMARKS:

RECEIVED
MAR 21 1977

If well telescopes please sketch and show depths.

GROUND LEVEL

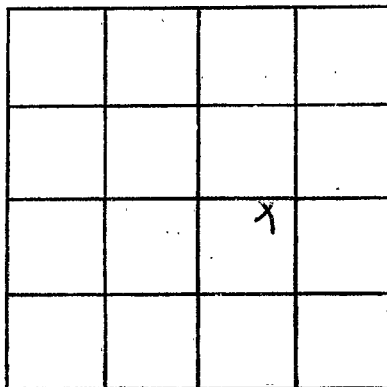

SECTION 18

Please indicate well location X.

ADDITIONAL INFORMATION

If more than one screen, show locations of each on sketch.