

WALTHALL
 A 2022
 2-10-77

MISSISSIPPI
 BOARD OF WATER COMMISSIONERS
 416 North State Street
 Jackson, Mississippi 39201

138

WATER WELL DRILLERS LOG

2-10 19 77 *F. Walthall Well Service* *Walthall*
 date well completed firm name county well located


LANDOWNER:	description of formations encountered	from	to
<i>Wallace Dunaway</i>			
<i>R. R. Jones, Mrs.</i> (mailing address)	<i>Red clay</i> <i>Red sand</i> <i>Coarse sand & gravel</i>	<i>0</i> <i>20</i> <i>70</i>	<i>20</i> <i>70</i> <i>80</i>
WELL LOCATION:			
sec. <u>9</u> T. <u>4</u> N. R. <u>10</u> E S W <u>2</u> miles <u>NE</u> of <u>Enon</u> (distance) (direction) (nearest town)			
WELL PURPOSE: <u>Home</u> (home, irrigation, municipal, industrial)			
WELL COMPLETION DATA:			
(1) diameter (inches) <u>4"</u>			
(2) total depth (feet) <u>80</u>			
(3) static water level (feet) <u>35</u> below above top of ground.			
(4) casing <u>PVC</u> , <u>72</u> , (material) (depth)			
<u>4</u> (size) if telescope see back.			
(5) screen <u>8</u> , <u>72</u> (length) (depth to top)			
<u>4</u> , <u>PVC</u> (size) (material)			
(6) pump <u>1/2</u> , <u>10</u> (HP) (yield gpm)			
<u>che</u> (type power)			
(7) electric log <u>no</u> (yes or no)			
(organization running log)			
(8) how well bottom plugged <u>Sand shot</u>			
DRILLERS REMARKS:			

RECEIVED
 MAR 30 1977

MISS. BD. OF WATER COMMISSIONERS

If well telescopes please sketch and show depths.

GROUND LEVEL

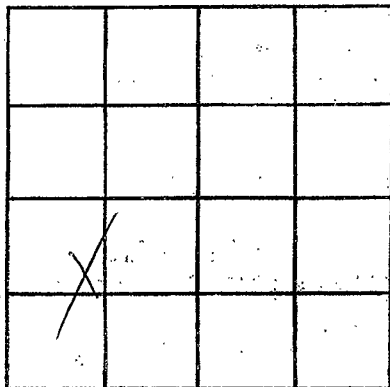

SECTION 9

Please indicate well location X.

ADDITIONAL INFORMATION

If more than one screen,
show locations of each on sketch.