

WALTHALL
 A 2023
 3/21/77

MISSISSIPPI
 BOARD OF WATER COMMISSIONERS
 416 North State Street
 138 Jackson, Mississippi 39201

22

WATER WELL DRILLERS LOG

March 21 1977 Rever Well Service Walthall
 date well completed firm name county well located

LANDOWNER:
C. D. Reed
Mt. Jylotown
 (mailing address)

description of formations encountered	from to	
	feet	feet
Red Clay	0	12
Red sand	12	45
mix of Chalk & sand	45	70
sand small gravel	70	93

WELL LOCATION:
 sec. 22 T-4 N R-10 E
3 miles E-SE of Enon
 (distance) (direction) (nearest town)

WELL PURPOSE: Trailer
 (home, irrigation, municipal, industrial)

WELL COMPLETION DATA:

(1) diameter (inches) 4.93

(2) total depth (feet) 93

(3) static water level (feet) 6.5 below top of ground.

(4) casing plastic bottom
 (material) (depth)

1 If telescope see back.
 (size)

(5) screen 6' 87'
 (length) (depth to top)

4' plastic
 (size) (material)

(6) pump 1/2 Sub 10.
 (HP) (yield gpm)

elect
 (type power)

(7) electric log no
 (yes or no)

(organization running log)

(8) how well bottom plugged
Washed plug


DRILLERS REMARKS:

RECEIVED

AUG 1 1977

If well telescopes please sketch and show depths.

GROUND LEVEL

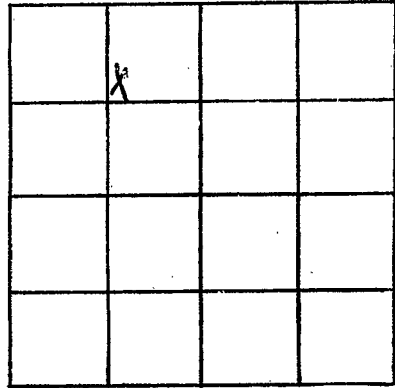

SECTION 22

Please indicate well location X.

ADDITIONAL INFORMATION

If more than one screen,
show locations of each on sketch.