

WALTHALL
 2024 A
 9-26-78

MISSISSIPPI
 BOARD OF WATER COMMISSIONERS
 416 North State Street
 Jackson, Mississippi 39201

WATER WELL DRILLERS LOG

Sept 26 1978 Reems well Co. Walthall
 date well completed firm name county well located

LANDOWNER:
Clyde Mabrey
Rt 3 Tylertown
 (mailing address)

description of formations encountered	from	to
clay	0	11
Red clay	11	30
sand & gravel	30	40
Red Chalk	40	47
Coarse sand	47	58


WELL LOCATION:
 sec. 20 T. 4 N R. 10 E
13 miles N-NW of Tylertown
 (distance) (direction) (nearest town)

WELL PURPOSE: house
 (home, irrigation, municipal, industrial)

WELL COMPLETION DATA:
 (1) diameter (inches) 4"
 (2) total depth (feet) 58
 (3) static water level (feet) 31 below above top of ground.
 (4) casing plastic bottom
 (material) (depth)
 (size) if telescope see back.
 (5) screen 5' 53'
 (length) (depth to top)
4" plastic
 (size) (material)
 (6) pump 1/2 Sub 10
 (HP) (yield gpm)
elect
 (type power)
 (7) electric log no
 (yes or no)
 (organization running log)

(8) how well bottom plugged
water plug


DRILLERS REMARKS:

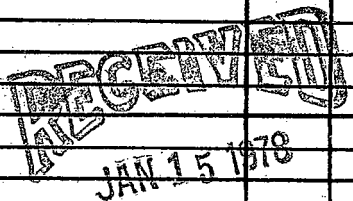

MISS. BD. OF WATER COMMISSIONERS

If well telescopes please sketch and show depths.

GROUND LEVEL

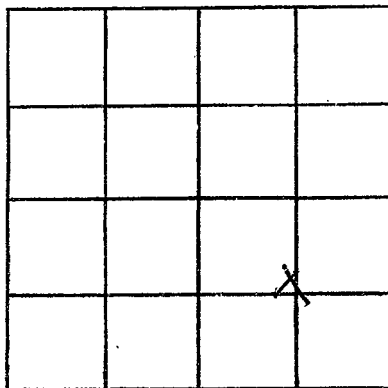

SECTION 20

Please indicate well location X.

ADDITIONAL INFORMATION

If more than one screen, show locations of each on sketch.