

WALTHALL

A 2025


5-23-78

MISSISSIPPI BOARD OF WATER COMMISSIONERS 416 North State Street Jackson, Mississippi 39201

WATER WELL DRILLERS LOG

May 23 1978 Reems Well Co Walthall date well completed firm name county well located


Table with 4 columns: LANDOWNER, WELL LOCATION, WELL PURPOSE, WELL COMPLETION DATA, and description of formations encountered. Includes handwritten entries for owner (Maurie Loue Jr.), location (6 miles N-NW of Scales), purpose (home), and well details (4" diameter, 117' depth).

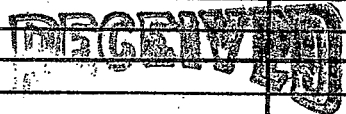

MAY 28 1978

If well telescopes please sketch and show depths.

GROUND LEVEL

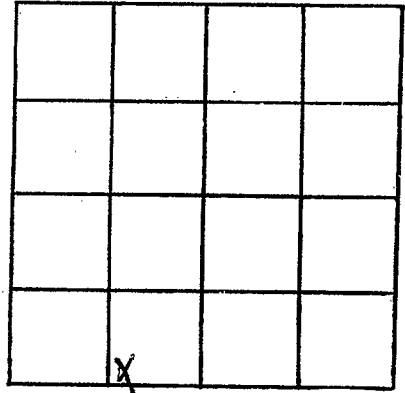

SECTION 14

Please indicate well location X.

ADDITIONAL INFORMATION

If more than one screen,  
show locations of each on sketch.