

WALTHALL  
 A 2030  
 6-1778

MISSISSIPPI  
 BOARD OF WATER COMMISSIONERS  
 416 North State Street  
 Jackson, Mississippi 39201

WATER WELL DRILLERS LOG

June 1 1978 Recess Well In Walthall  
 date well completed firm name county well located

LANDOWNER:	description of formations encountered	from	to
<u>Mr. Albrecht Richardson</u>	<u>Red Clay</u>	<u>0</u>	<u>18</u>
<u>Mr 3 Jayers</u> (mailing address)	<u>Red sand</u>	<u>18</u>	<u>76</u>
	<u>scout gravel</u>	<u>76</u>	<u>94</u>

WELL LOCATION:  
 sec 26 T 4 N R 10 E  
3 1/2 miles S-SW of Sartinville  
 (distance) (direction) (nearest town)

WELL PURPOSE: house  
 (home, irrigation, municipal, industrial)

- WELL COMPLETION DATA:
- (1) diameter (inches) 4"
  - (2) total depth (feet) 94
  - (3) static water level (feet) 161 below top of ground.
  - (4) casing plastic bottom  
 (material) (depth)
  - if telescope see back.  
 (size)
  - (5) screen 5', 89'  
 (length) (depth to top)
  - 4", plastic  
 (size) (material)
  - (6) pump 1/2 HP, 10 yield gpm  
 (type power)
  - (7) electric log no  
 (yes or no)
  - (organization running log)


(8) how well bottom plugged  
wooden plug

DRILLERS REMARKS:  
no remarks

RECEIVED  
 AUG 28 1978  
 MISS. BD. OF WATER COMM

If well telescopes please sketch and show depths.

GROUND LEVEL

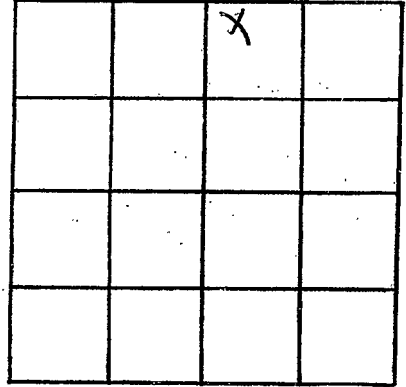

SECTION 26

Please indicate well location X.

ADDITIONAL INFORMATION

If more than one screen,  
show locations of each on sketch.