

WALTHALL

A 2038

9-8-78

MISSISSIPPI BOARD OF WATER COMMISSIONERS  
416 North State Street  
Jackson, Mississippi 39201

well ②

WATER WELL DRILLERS LOG

Sept 8 1978  
date well completed

Primmer Well Service  
firm name

Walthall  
county well located


LANDOWNER:	description of formations encountered	from	to
Tammes Whitte Rt 3 Fayetteville (mailing address)	Clay & gravel Red sand lumpy clay	0 27 68	22 68 116
WELL LOCATION: sec 29 T 4 N R 10 E 12 miles N-NW of Fayetteville (distance) (direction) (nearest town)	gravel & sand	115	127
WELL PURPOSE: windmill (home, irrigation, municipal, industrial)			
WELL COMPLETION DATA:			
(1) diameter (inches) 4"			
(2) total depth (feet) 127'			
(3) static water level (feet) 77' below top of ground.			
(4) casing plastic bottom (material) (depth) if telescope see back. (size)			
(5) screen 5' 122' (length) (depth to top)			
4" plastic (size) (material)			
(6) pump 1/2 hp (HP) (yield, gpm) windmill (type power)			
(7) electric log no (yes or no)			
(organization running log)			
(8) how well bottom plugged wooden plug			
DRILLERS REMARKS:			

RECEIVED  
JAN 15 1978

MISS. BD. OF WATER COMMISSIONERS

If well telescopes please sketch and show depths.

GROUND LEVEL

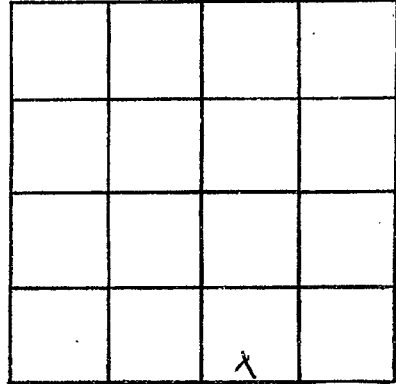

SECTION 29

Please indicate well location X.

ADDITIONAL INFORMATION

If more than one screen,  
show locations of each on sketch.